

MISSISSIPPI DEPARTMENT OF NATURAL RESOURCES

Bureau of Land and Water Resources

Southport Mall

P.O. Box 10631

Jackson, Mississippi 39209

WATER WELL DRILLERS LOG

COASTAL DRILLING & SERVICE CO.

Harrison
C
2036

RT. 11, BOX 81

county well located

12/5/85 19
date well completed

BILOKI, MS 39532

LANDOWNER: C. Moseley
Hickman Rd.
Saucier, MS
(mailing address)

description of formations encountered

from

to

WELL LOCATION:

sec. 9 T. 2 N. R. 11 E. S. 5 W.
Hwy 19 miles of (nearest town)

WELL PURPOSE: Home
(home, irrigation, municipal, industrial)

WELL COMPLETION DATA:


- (1) diameter (inches) 2"
- (2) total depth (feet) 290
- (3) static water level (feet) 10 below top of ground.
- (4) casing PVC, 250 (material), (depth)
- (size) If telescope see back.
- (5) screen 10" 280 (length), (depth to top)
- 2" PVC (size), (material)
- (6) pump 1 (HP), 8 (yield gpm)
- E/C (type power)
- (7) electric log NO (yes or no)
- (organization running log)
- (8) how well bottom plugged. 2" back wash well.

DRILLERS REMARKS:

RECEIVED
FEB 14 1986

If well telescopes please sketch and show depths.

GROUND LEVEL

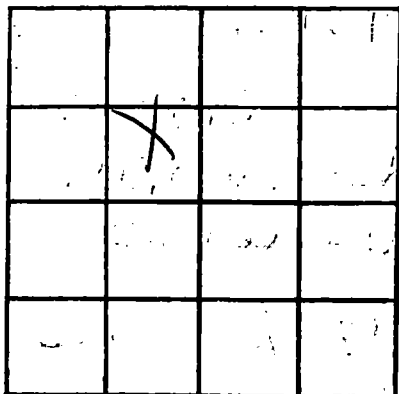

SECTION _____

Please indicate well location X.

ADDITIONAL INFORMATION

If more than one screen, show locations of each on sketch.