

MISSISSIPPI DEPARTMENT OF NATURAL RESOURCES

Bureau of Land and Water Resources

Southport Mall

P.O. Box 10631

Jackson, Mississippi 39209

WATER WELL DRILLERS LOG

Harrison  
C2037

1-23

1986 Broden Pump & Well Dr.

Harrison

date well completed

firm name

county well located

LANDOWNER: Mike Thompson

Lakeview Drive - RR.  
Saucier, Miss. 39574  
(mailing address)

description of formations encountered

from

to

<u>Surface Sand</u>	<u>0</u>	<u>8</u>
<u>Red Clay</u>	<u>8</u>	<u>44</u>
<u>White Clay</u>	<u>44</u>	<u>80</u>
<u>Sand</u>	<u>80</u>	<u>85</u>
<u>Blue Clay</u>	<u>85</u>	<u>220</u>
<u>Grey Sand</u>	<u>220</u>	<u>286</u>

WELL LOCATION:

sec. 31 T. 4 S. R. 11 W.  
1 1/2 miles N of Saucier  
(distance) (direction) (nearest town)

WELL PURPOSE: Home  
(home, irrigation, municipal, industrial)

WELL COMPLETION DATA:

- (1) diameter (inches) 2"
- (2) total depth (feet) 286
- (3) static water level (feet) 100 below above top of ground.
- (4) casing PVC Total  
(material) (depth)  
2" if telescope see back.  
(size)
- (5) screen 10 266  
(length) (depth to top)  
2" PVC .0085/10  
(size) (material)
- (6) pump 1 6  
(HP) (yield gpm)  
220V 1Ø  
(type power)
- (7) electric log No  
(yes or no)

(organization running log)

(8) how well bottom plugged 2" PVC Sand Shale

DRILLERS REMARKS:


10 FT Tailpipe

**RECEIVED**  
APR - 3 1986

Department of Natural Resources  
Bureau of Land & Water Resources

If well telescopes please sketch and show depths.

GROUND LEVEL

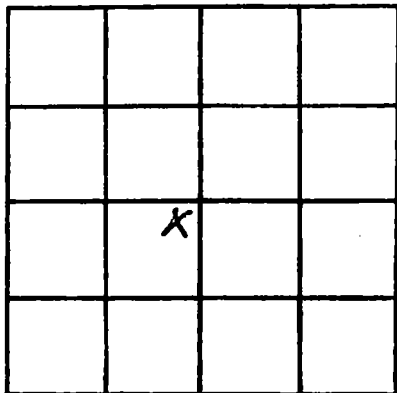

SECTION 31

Please indicate well location X.

ADDITIONAL INFORMATION

If more than one screen, show locations of each on sketch.