

MISSISSIPPI DEPARTMENT OF NATURAL RESOURCES

Bureau of Land and Water Resources

Southport Mall

P.O. Box 10631

Jackson, Mississippi 39209

WATER WELL DRILLERS LOG

HARRISON  
C  
2038

7/1/85 19 Lyman Well Co. Harrison  
date well/completed firm name county well located

LANDOWNER: Suther Scott  
P.O. Box 403  
New Augusta, MS 39462  
(mailing address)

description of formations encountered	from	to
	<u>gray clay</u> <u>over sand</u>	<u>0</u> <u>46</u>

WELL LOCATION:  
sec. 11 T. 5 N. R. 11 E.  
S. W.  
7 miles South of Sammet  
(distance) (direction) (nearest town)

WELL PURPOSE:  
(home, irrigation, municipal, industrial)

WELL COMPLETION DATA:

(1) diameter (inches) 2 1/2

(2) total depth (feet) 70

(3) static water level (feet) 30 below/above top of ground.

(4) casing PVC 70  
(material) (depth)  
2 1/2 (size) If telescope see back.

(5) screen 10' 70  
(length) (depth to top)  
2 PVC  
(size) (material)

(6) pump 1 10  
(HP) (yield gpm)  
Electric  
(type power)

(7) electric log no  
(yes or no)  
no  
(organization running log)

(8) how well bottom plugged SAND  
SAND


**RECEIVED**  
APR 20 1986

DRILLERS REMARKS:

Department of Natural Resources  
Bureau of Land & Water Resources

If well telescopes please sketch and show depths.

GROUND LEVEL

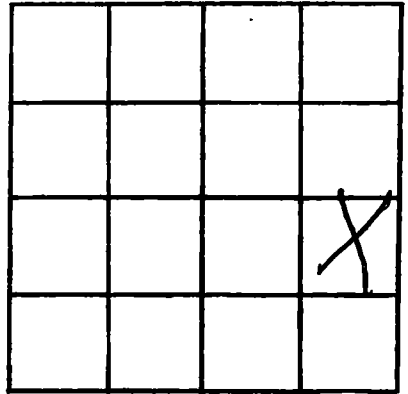

SECTION 11

Please indicate well location X.

ADDITIONAL INFORMATION

If more than one screen,  
show locations of each on sketch.