

MISSISSIPPI DEPARTMENT OF NATURAL RESOURCE

Bureau of Land and Water Resources

Southport Mall

P.O. Box 10631

Jackson, Mississippi 39209

WATER WELL DRILLERS LOG

HARRISON
C
2039

3-5 1986 Broden Pump Well Co. Harrison
 date well completed firm name county well located

LANDOWNER: Cheryl Palmer
 Rt. 2 Box 82-75
 Saucier, Miss. 39574
 (mailing address)

description of formations encountered	from	to
Red Sand	0	45
White Clay	45	114
Sand	114	120
Blue Clay	120	238
Sand	238	250
Blue Clay	250	310
Cry Sand	310	360

WELL LOCATION:
 sec. 21 T. 5 S. R. 11 E.
 3 miles SE of Saucier
 (distance) (direction) (nearest town)

WELL PURPOSE: Home
 (home, irrigation, municipal, industrial)

WELL COMPLETION DATA:

(1) diameter (inches) 2"
 (2) total depth (feet) 360
 (3) static water level (feet) 80 below top of ground.
 (4) casing PVC Total, 2" (size) if telescope see back.
 (5) screen 10ft, 350 (length), (depth to top)
 2" PVC - 100# 5/8" (size), (material)
 (6) pump - Well Capped (HP), (yield gpm)
 (7) electric log - (yes or no)
 (organization running log)
 (8) how well bottom plugged 2" PVC Sand Shank


RECEIVED
 APR - 3 1986

Department of Natural Resources
 Bureau of Land & Water Resources

DRILLERS REMARKS:

If well telescopes please sketch and show depths.

GROUND LEVEL

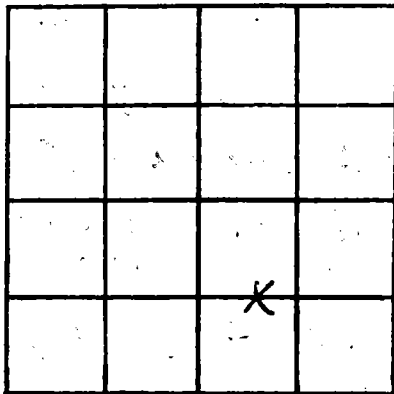

SECTION 21

Please indicate well location X.

ADDITIONAL INFORMATION

A series of horizontal lines for writing additional information, starting below the 'ADDITIONAL INFORMATION' header and extending to the bottom of the page.

If more than one screen, show locations of each on sketch.