

MISSISSIPPI DEPARTMENT OF NATURAL RESOURCES

Bureau of Land and Water Resources

Southport Mall

P.O. Box 10631

Jackson, Mississippi 39209

WATER WELL DRILLERS LOG

Harrison
C
2043

8/12/86
 date well completed

COASTAL DRILLING & SERVICE CO.

Harrison
 county well located

LANDOWNER: Herman Williams
farm at saucier
saucier, ms
 (mailing address)

DESCRIPTION OF FORMATIONS
 encountered

Description of formations encountered	from	to
top soil	1	3
red clay	3	90
soft blue clay	90	240
hard blue clay	240	460
fine water sand	460	480
good water sand	480	500


WELL LOCATION:
 sec. 6 T. 5 N. R. 11 E.
 S W

saucier miles of (distance) (direction) of (nearest town)

WELL PURPOSE: home
 (home, irrigation, municipal, industrial)

WELL COMPLETION DATA:

- (1) diameter (inches) 4 x 2
- (2) total depth (feet) 500
- (3) static water level (feet) 15 below above top of ground.
- (4) casing pvc 485
 (material) (depth)
- 4 x 2 (size) if telescope see back.
- (5) screen 15' 485
 (length) (depth to top)
- 2" (size) pvc (material)
- (6) pump 1 (HP) 10 (yield gpm)
- etc. (type power)
- (7) electric log no
 (yes or no)
- (organization running log)
- (8) how well bottom plugged 2" back
wash valves

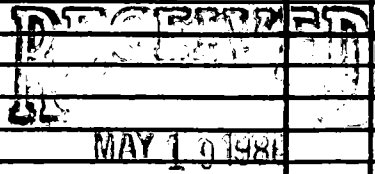

Department of Natural Resources
 Bureau of Land & Water Resources

DRILLERS REMARKS:

