

MISSISSIPPI DEPARTMENT OF NATURAL RESOURCES
 Bureau of Land and Water Resources
 Southport Mall
 P.O. Box 10631
 Jackson, Mississippi 39209
WATER WELL DRILLERS LOG

Harrison
C
2044

3 28 1986 Parnell Anderson Harrison
 date well completed firm name county well located

LANDOWNER: Ryan Ferrell
Saucier
Mis.
 (mailing address)

description of formations encountered	from	to
<u>Top soil</u>	<u>0</u>	<u>2</u>
<u>Clay</u>	<u>2</u>	<u>24</u>
<u>Sand</u>	<u>24</u>	<u>33</u>
<u>Blue Clay</u>	<u>33</u>	<u>196</u>
<u>Sand</u>	<u>196</u>	<u>220</u>

WELL LOCATION:
 sec 21 T. 5 N. R. 11 E.
4 miles S-E of Saucier
 (distance) (direction) (nearest town)

WELL PURPOSE: Home
 (home, irrigation, municipal, industrial)

WELL COMPLETION DATA:

- (1) diameter (inches) 2
- (2) total depth (feet) 220
- (3) static water level (feet) 55 ^{below} ~~above~~ top of ground
- (4) casing PVC, 210,
 (material) (depth)
 (size) if telescope see back.
- (5) screen 10, 210,
 (length) (depth to top)
2, PVC
 (size) (material)
- (6) pump 1, 9
 (HP) (yield gpm)
Ec
 (type power)
- (7) electric log NO
 (yes or no)
 (organization running log)
- (8) how well bottom plugged Backwash valve


RECORDED
 JUN 12 1986

Department of Natural Resources
 Bureau of Land & Water Resources

DRILLERS REMARKS:

If well telescopes please sketch and show depths.

GROUND LEVEL

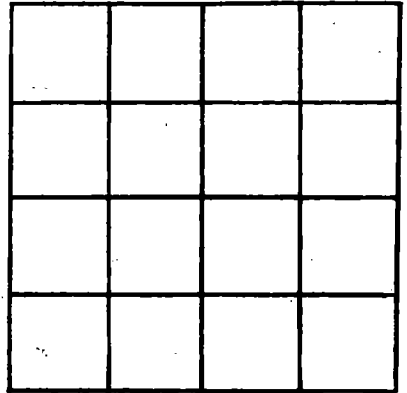

SECTION _____

Please indicate well location X.

ADDITIONAL INFORMATION

If more than one screen, show locations of each on sketch.