

MISSISSIPPI DEPARTMENT OF NATURAL RESOURCES

Bureau of Land and Water Resources

Southport Mall

P.O. Box 10631

Jackson, Mississippi 39209

WATER WELL DRILLERS LOG

Harrison  
C 2047

8/8/86 19 Lyman Well Harrison  
date well completed firm name county well located

LANDOWNER: Margaret Bliss  
Rt. 2, Box 82-22  
Saucier 39574  
(mailing address)

description of formations encountered	from	to
Top soil		1'
Sandy Red Clay	1'	13'
Red Sand	13'	48'
Yellow White Clay	48'	66'
<del>Sand</del> Yellow Sand	66'	109'
Blue Clay	109'	164'
Sand	164'	180'

WELL LOCATION:  
sec. 21 T. 5 N R. 11 E  
5 miles E of Saucier  
(distance) (direction) (nearest town)

WELL PURPOSE: Home  
(home, irrigation, municipal, industrial)

WELL COMPLETION DATA:

- (1) diameter (inches) 2"
- (2) total depth (feet) 180'
- (3) static water level (feet) 50' below above top of ground.
- (4) casing PVC, 170'  
(material) (depth)  
2" if telescope see back.  
(size)
- (5) screen 10', 170'  
(length) (depth to top)  
2", PVC  
(size) (material)
- (6) pump 1, 10  
(HP) (yield gpm)  
electric  
(type power)
- (7) electric log No  
(yes or no)

RECEIVED

OCT 28 1986


Department of Natural Resources  
Bureau of Land & Water Resources

(organization running log)  
(8) how well bottom plugged Sand  
Shark

DRILLERS REMARKS: None

If well telescopes please sketch and show depths.

GROUND LEVEL

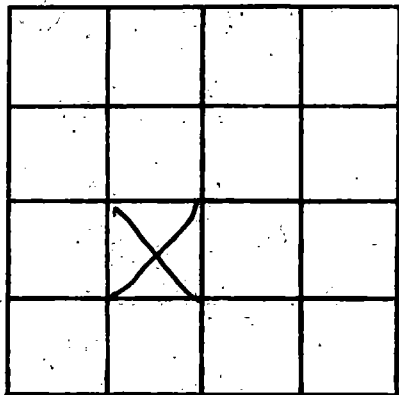

SECTION 21

Please indicate well location X.

ADDITIONAL INFORMATION

Lined area for additional information.

If more than one screen, show locations of each on sketch.