

HARRISON  
C253

Bureau of Land and Water Resources  
Southport Mall  
P.O. Box 10631  
Jackson, Mississippi 39209  
**WATER WELL DRILLERS LOG**

3-17 1986 No Braden Pump Well Harrison  
date well completed firm name county well located

LANDOWNER: George Cooper  
P.O. Box 82  
Saucier Miss. 39574  
(mailing address)

description of formations encountered	from	to
Surface	0	6
White Clay	6	55
Brown Sand	55	92
Blue Clay	92	100

WELL LOCATION:  
sec. 17 T. S N. R. 11 E.  
2 miles SE of Saucier  
(distance) (direction) (nearest town)

WELL PURPOSE: Home  
(home, irrigation, municipal, industrial)

**WELL COMPLETION DATA:**

- (1) diameter (inches) 2"
  - (2) total depth (feet) 100
  - (3) static water level (feet) 40 below top of ground.
  - (4) casing PVC 80  
(material) (depth)  
2" If telescope see back.  
(size)
  - (5) screen 10 80  
(length) (depth to top)  
2" PVC  
(size) (material)
  - (6) pump 1 8  
(HP) (yield gpm)  
200 V 1Ø  
(type power)
  - (7) electric log No  
(yes or no)
- (organization running log)
- (8) how well bottom plugged  
PVC Sand Stack

DRILLERS REMARKS:  
10 FT Fair pipe


**RECEIVED**

FEB 25 1987

Department of Natural Resources  
Bureau of Land & Water Resources

If well telescopes please sketch and show depths.

GROUND LEVEL

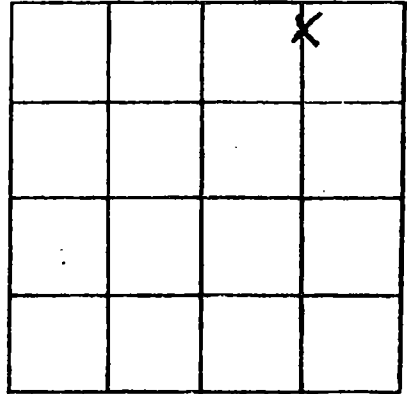

SECTION 17

Please indicate well location X.

ADDITIONAL INFORMATION

A series of horizontal lines for recording additional information.

If more than one screen, show locations of each on sketch.