

MISSISSIPPI DEPARTMENT OF NATURAL RESOURCES

Bureau of Land and Water Resources

COUNTY WELL LOCATED Harrison	
WELL NUMBER C 2057	CODED 7
DATE WELL COMPLETED 10/29/86	

PERMIT NUMBER
NAME OF DRILLING FIRM Lyman Well Co

P.O. Box 10631
Jackson, Mississippi 39209
WATER WELL DRILLERS LOG

NAME & MAILING ADDRESS OF LANDOWNER James E Scarborough			
Rt. 1, Box 773			
Saucier, MS 39574			
WELL LOCATION:	SEC	TOWNSHIP	RANGE
	19	5	N 11 E
DISTANCE	DIRECTION	NEAREST TOWN	
11 Miles	North	of Gulfport	
OTHER LANDMARK			
WELL PURPOSE: Home, Irrigation, Municipal, Industrial, Fish Pond, etc. home			

PUMP DATA		
PUMP TYPE (Circle One): Submersible, Turbine, Jet Flowing Well, Other (Describe) _____		
POWER TYPE (Circle One): Electric , Tractor, Diesel, Gasoline, Butane, Other (Describe) _____		
Pump Capacity (GPM) 12	No. of Stages 2	Setting Depth 80 FT.
PUMP TEST		
Well yielded _____ GPM with a drawdown of _____ ft. after _____ hours of pumping		

WELL DATA		
Well Depth 312	Casing Diameter (In.) 2	Casing Length (Ft.) 302
Type of Casing PVC	Hole Depth 312	Depth to Static Water Level 63
TYPE OF COMPLETION: (Circle One or More): Natural Development , Underreamed, Telescoped, Open Hole, Other		
Top of Lap Pipe or Reduction in Casing		
FEET	IF TELESCOPED OR MORE THAN ONE SCREEN: USE BACK PAGE	

LOG DATA	
TYPE OF LOG RUN (Circle One): No Log Run, Electric, Gamma Ray, Density, Sonic, Neutron, Other (Describe) _____	
Name of Organization Running Log	

SCREEN DATA		
Diameter - Inches 2	Length - Feet 10	Slot Size - Inches 6
Screen Type PVC	Depth to Bottom - Feet 312	


GEOLOGIC DATA (Office Use Only)			
Surface Elev.	Geologic Unit	Unit Thickness	Depth to Top
Subs. SWL	Date	Analysis	Aquifer Test
Driller's Remarks None			

DESCRIPTION OF FORMATIONS ENCOUNTERED	FROM	TO	FORMATIONS (Continued)	FROM	TO
Top soil		1'	RECEIVED AUG 25 1987 Department of Natural Resources Bureau of Land & Water Resources		
Sandy clay	1'	6'			
Orange or Blue clay	6'	21'			
Blue clay	21'	101'			
Sand	101'	106'			
Blue clay	106'	278'			
Sand	278'	312'			

IF MORE SPACE IS NEEDED, USE BACK

If well telescopes please
sketch and show depths.

GROUND LEVEL

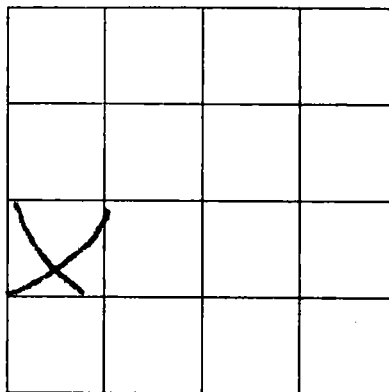

SECTION 19

Please indicate well location X.

ADDITIONAL INFORMATION

If more than one screen,
show location of each on sketch.