

Amason
Cobby

MISSISSIPPI DEPARTMENT OF NATURAL RESOURCES
Bureau of Land and Water Resources
Southport Mall
P.O. Box 10631
Jackson, Mississippi 39209
WATER WELL DRILLERS LOG

4-24-87 19 P. J. Moore HAVERHILL
date well completed firm name county well located

LANDOWNER: Eugenie W. Block
 Hwy 49 Starcke, MS

description of formations encountered	from	to
TOP Soil red clay	0	20
Red clay	20	40
Red sand	40	60
White & Blue clay	60	100
Blue clay	100	290
Med sand	290	330

(mailing address)
WELL LOCATION:
sec. 19 T 5 N R 11 E
2 1/2 miles S of Starcke
(distance) (direction) (nearest town)

WELL PURPOSE:
(home) Irrigation, municipal, industrial

WELL COMPLETION DATA:
(1) diameter (Inches) 4"
(2) total depth (feet) 330
(3) static water level (feet) 90 ^{below} _{above} top of ground.
(4) casing PVC, 330
(material) (depth)
_____ If telescope see back.
(size)
(5) screen 10, 330'
(length) (depth to top)
4", PVC
(size) (material)
(6) pump 1, 19
(HP) (yield gpm)
E
(type power)
(7) electric log _____
(yes or no)

(organization running log)
(8) how well bottom plugged Blw

RECEIVED


NOV 04 1987

Department of Natural Resources
Bureau of Land & Water Resources

DRILLERS REMARKS:

If well telescopes please sketch and show depths.

GROUND LEVEL

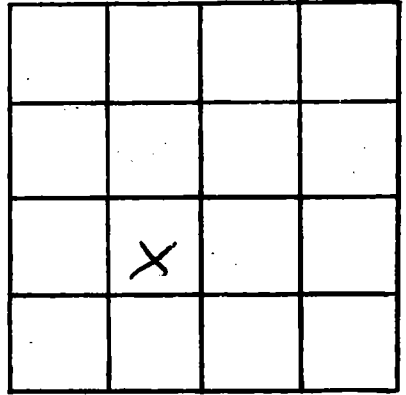

SECTION 19

Please indicate well location X.

ADDITIONAL INFORMATION

If more than one screen, show locations of each on sketch.