

MISSISSIPPI DEPARTMENT OF NATURAL RESOURCES

Bureau of Land and Water Resources

COUNTY WELL LOCATED <i>Harrison</i>	
WELL NUMBER <i>C 2075</i>	CODED
DATE WELL COMPLETED <i>2-14-90</i>	

PERMIT NUMBER
NAME OF DRILLING FIRM <i>Mo B Drilling Co.</i>

P.O. Box 10631
Jackson, Mississippi 39209
WATER WELL DRILLERS LOG

NAME & MAILING ADDRESS OF LANDOWNER <i>Michael Barton</i>			
<i>20608 Scarborough Rd</i>			
<i>Saucier, Miss. 39574</i>			
WELL LOCATION	SEC	TOWNSHIP	RANGE
	<i>29</i>	<i>5 N</i>	<i>11 W</i>
DISTANCE	DIRECTION	NEAREST TOWN	
<i>3</i> Miles	<i>S</i>	of <i>Saucier</i>	
OTHER LANDMARK			
WELL PURPOSE: Home, Irrigation, Municipal, Industrial, Fish Pond, etc. <i>Home</i>			

PUMP DATA		
PUMP TYPE (Circle One): Submersible, Turbine, <input checked="" type="radio"/> Jet, Flowing Well, Other (Describe) _____		
POWER TYPE (Circle One): <input checked="" type="radio"/> Electric, Tractor, Diesel, Gasoline, Butane, Other (Describe) _____ H/P <i>/</i>		
Pump Capacity (GPM) <i>8</i>	No. of Stages <i>2</i>	Setting Depth _____ FT.
PUMP TEST		
Well yielded _____ GPM with a drawdown of _____ ft. after _____ hours of pumping		

WELL DATA		
Well Depth <i>370</i>	Casing Diameter (In.) <i>2</i>	Casing Length (Ft.) <i>310</i>
Type of Casing <i>PRC</i>	Hole Depth <i>370</i>	Depth to Static Water Level <i>78</i>
TYPE OF COMPLETION: (Circle One or More): <input checked="" type="checkbox"/> Gravel Packed, <input type="checkbox"/> Underreamed, <input type="checkbox"/> Telescoped, <input checked="" type="checkbox"/> Natural Development, <input type="checkbox"/> Open Hole, <input type="checkbox"/> Other (Describe) _____		
Top of Lap Pipe or Reduction in Casing _____ FEET		
IF TELESCOPED OR MORE THAN ONE SCREEN: USE BACK PAGE		

LOG DATA	
TYPE OF LOG RUN (Circle One): Electric, Gamma Ray, Density, Sonic, <input checked="" type="radio"/> No Log Run, Neutron, Other (Describe) _____	
Name of Organization Running Log	

SCREEN DATA		
Diameter - Inches <i>2</i>	Length - Feet <i>10</i>	Slot Size - Inches <i>.008</i>
Screen Type <i>PRC WDP</i>	Depth to Bottom - Feet <i>370</i>	

GEOLOGIC DATA (Office Use Only)			
Surface Elev.	Geologic Unit	Unit Thickness	Depth to Top
Subs. SWL	Date	Analysis	Aquifer Test

DESCRIPTION OF FORMATIONS ENCOUNTERED	FROM	TO
<i>Surface</i>	<i>0</i>	<i>6</i>
<i>Red Clay</i>	<i>6</i>	<i>26</i>
<i>Blue Clay</i>	<i>26</i>	<i>210</i>
<i>Fire Sand</i>	<i>210</i>	<i>230</i>
<i>Blue Clay</i>	<i>230</i>	<i>280</i>
<i>Coarse Grey Sand</i>	<i>280</i>	<i>370</i>


Driller's Remarks		

FORMATION ENCOUNTERED	FROM	TO
<div style="font-size: 2em; font-weight: bold; opacity: 0.5; transform: rotate(-5deg); display: inline-block;">RECEIVED</div> <div style="font-size: 1.5em; font-weight: bold; margin-top: 10px;">APR 02 1990</div> <div style="text-align: center; margin-top: 10px;"> Department of Natural Resources Bureau of Land & Water Resources </div>		

IF MORE SPACE IS NEEDED, USE BACK

If well telescopes please sketch and show depths.

GROUND LEVEL

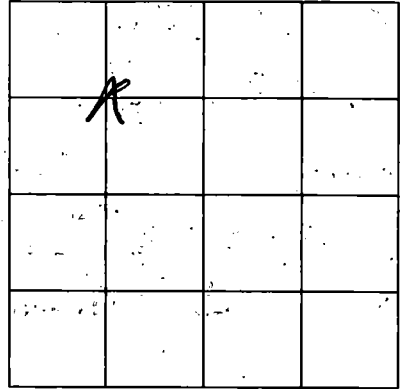

SECTION 29

Please indicate well location X.

ADDITIONAL INFORMATION

Lined area for additional information.

Faint, illegible text or stamp, possibly a date or location.

If more than one screen, show location of each on sketch.