

MISSISSIPPI DEPARTMENT OF NATURAL RESOURCES

Bureau of Land and Water Resources

| | |
|------------------------------------------|-------|
| COUNTY WELL LOCATED Harrison | |
| WELL NUMBER C 2079 | CODED |
| DATE WELL COMPLETED July 24-89 | |

| |
|---------------------------------------------------------|
| PERMIT NUMBER 0239 |
| NAME OF DRILLING FIRM McMill Pump & Wells |

P.O. Box 10631
Jackson, Mississippi 39209
WATER WELL DRILLERS LOG

| | | |
|-----------------------------------------------------------------------------------------------------------|--------------|----------------|
| NAME & MAILING ADDRESS OF LANDOWNER John Adam Saucier Miss. Ms. | | |
| WELL LOCATION: SEC | TOWNSHIP | RANGE |
| 32 | 4 N | 11 E |
| DISTANCE | DIRECTION | NEAREST TOWN |
| 2 Miles | north | Saucier |
| OTHER LANDMARK | | |
| WELL PURPOSE: <input checked="" type="checkbox"/> Home Irrigation, Municipal, Industrial, Fish Pond, etc. | | |

| PUMP DATA | | |
|-----------------------------------------------------------------------------------------------------------------------------------------------|---------------------------|---------------------------------|
| PUMP TYPE (Circle One): Submersible, Turbine, <input checked="" type="radio"/> Jet, Flowing Well, Other (Describe) _____ | | |
| POWER TYPE (Circle One): <input checked="" type="radio"/> Electric, Tractor, Diesel, Gasoline, Butane, Other (Describe) _____ H/P _____ | | |
| Pump Capacity (GPM) 11 | No. of Stages 2 | Setting Depth 60' FT. |
| PUMP TEST | | |
| Well yielded 11 GPM with a drawdown of 10 ft. after 1 hours of pumping | | |

| WELL DATA | | |
|-------------------------------------------------------------------------------------------------------------------------------------------------------------------|------------------------------------|-------------------------------------------|
| Well Depth 260 | Casing Diameter (In.) 2" | Casing Length (Ft.) 20' |
| Type of Casing PVC | Hole Depth 260 | Depth to Static Water Level 40' |
| TYPE OF COMPLETION: (Circle One or More): Gravel Packed, Underreamed, Telescoped, <input checked="" type="checkbox"/> Natural Development, Open Hole, Other | | |
| Top of Lap Pipe or Reduction in Casing _____ | | |
| FEET IF TELESCOPED OR MORE THAN ONE SCREEN: USE BACK PAGE | | |

| LOG DATA | |
|---------------------------------------------------------------------------------------------------------------------------------------------------------|--|
| TYPE OF LOG RUN (Circle One): Electric, Gamma Ray, Density, Sonic, Neutron, Other (Describe) _____ <input checked="" type="checkbox"/> No Log Run | |
| Name of Organization Running Log _____ | |

| SCREEN DATA | | |
|--------------------------------|---------------------------------------|------------------------------------|
| Diameter - Inches 2" | Length - Feet 10' | Slot Size - Inches .0006 |
| Screen Type PVC | Depth to Bottom - Feet 260' | |

| GEOLOGIC DATA (Office Use Only) | | | |
|---------------------------------|---------------|----------------|--------------|
| Surface Elev. | Geologic Unit | Unit Thickness | Depth to Top |
| Subs. SWL | Date | Analysis | Aquifer Test |


| |
|-------------------|
| Driller's Remarks |
| |
| |

| DESCRIPTION OF FORMATIONS ENCOUNTERED | FROM | TO |
|---------------------------------------|------------|------------|
| mud | 0 | 10 |
| sand | 10 | 60 |
| mud | 60 | 130 |
| sand | 130 | 260 |
| | | |
| | | |
| FORMATIONS (Continued) | FROM | TO |
|------------------------------------------------------------------------------|------|----|
| <div style="font-size: 2em; font-weight: bold; opacity: 0.5;">RECEIVED</div> | | |
| <div style="font-size: 1.5em; font-weight: bold;">AUG 16 1990</div> | | |
| Department of Natural Resources Bureau of Land & Water Resources | | |
| IF MORE SPACE IS NEEDED, USE BACK | | |

If well telescopes please sketch and show depths.

GROUND LEVEL

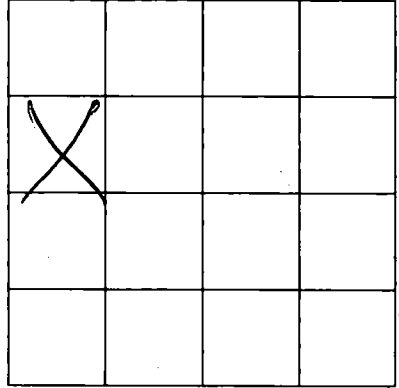

SECTION _____

Please indicate well location X.

ADDITIONAL INFORMATION

If more than one screen, show location of each on sketch.