

MISSISSIPPI DEPARTMENT OF ENVIRONMENTAL QUALITY
Bureau of Land and Water Resources

P. O. Box 10631
Jackson, MS 39289-0631
WATER WELL DRILLERS LOG

COUNTY WELL LOCATED
Harrison

WELL NUMBER <i>C 2094</i>	CODED
DATE WELL COMPLETED <i>6-17-89</i>	

PERMIT NUMBER _____

Coastal Drilling & Service Co.
8456 Woolmarket Biloxi Road
Biloxi, Mississippi 39532

NAME & MAILING ADDRESS OF LANDOWNER
Thomas Turine
Hwy 67
Biloxi, Ms

WELL LOCATION: SEC TOWNSHIP RANGE
Harrison 24 5 N 11 E

DISTANCE _____ MILES _____ of *Success*

OTHER LANDMARK
Hwy 67

WELL PURPOSE (Home, Irrigation, Municipal, Industrial, Fish Pond, etc.) _____

PUMP DATA

PUMP TYPE (Circle One):
Submersible, Turbine, *Jet* Flowing Well,
Other (Describe) _____

POWER TYPE (Circle One):
 Electric, Tractor, Diesel, Gasoline, Butane,
Other (Describe) _____ H/P _____

Pump Capacity (GPM) <i>12</i>	No. of Stages <i>3</i>	Setting Depth <i>60</i> FT.
----------------------------------	---------------------------	--------------------------------

PUMP TEST
Well yielded _____ *12* GPM with
a drawdown of _____ *0* ft.
after _____ *6* hours of pumping

WELL DATA

Well Depth <i>740'</i>	Casing Diameter (In.) <i>2'</i>	Casing Length (Ft.) <i>720'</i>
Type of Casing <i>PVC</i>	Hole Depth <i>740'</i>	Depth to Static Water Level <i>40'</i>

TYPE OF COMPLETION: (Circle One or More):
 Natural Development, Gravel Packed, Underreamed, Telescoped,
 Open Hole, Other

Top of Lap Pipe or Reduction in Casing _____

FEET IF TELESCOPED OR MORE THAN ONE SCREEN: USE BACK PAGE

LOG DATA

TYPE OF LOG RUN (Circle One):
No Log Run, Electric, Gamma Ray, Density, Sonic, Neutron,
Other (Describe) _____

Name of Organization Running Log _____

SCREEN DATA

Diameter - Inches <i>2"</i>	Length - Feet <i>10'</i>	Slot Size - Inches <i>.008</i>
Screen Type <i>PVC</i>	Depth to Bottom - Feet <i>740'</i>	

GEOLOGIC DATA (Office Use Only)

Surface Elev.	Geologic Unit	Unit Thickness	Depth to Top
Subs. SWL	Date	Analysis	Aquifer Test

Driller's Remarks
None


DESCRIPTION OF FORMATIONS ENCOUNTERED	FROM	TO
<i>top soil</i>	<i>1'</i>	<i>3'</i>
<i>soft sand</i>	<i>3'</i>	<i>18'</i>
<i>White sand</i>	<i>18'</i>	<i>32'</i>
<i>soft blue clay</i>	<i>32'</i>	<i>200'</i>
<i>hard blue clay</i>	<i>200'</i>	<i>480'</i>
<i>fine water sand</i>	<i>480'</i>	<i>540'</i>
<i>hard blue clay</i>	<i>540'</i>	<i>680'</i>
<i>fine water sand</i>	<i>680'</i>	<i>710'</i>
<i>Coarse water sand</i>	<i>710'</i>	<i>740'</i>

FORMATIONS (Continued)

FROM	TO
RECEIVED	
FEB 26 1992	
Dept. of Environmental Quality Bureau of Land & Water Resources	
IF MORE SPACE IS NEEDED, USE BACK	

If well telescopes please sketch and show depths.

GROUND LEVEL

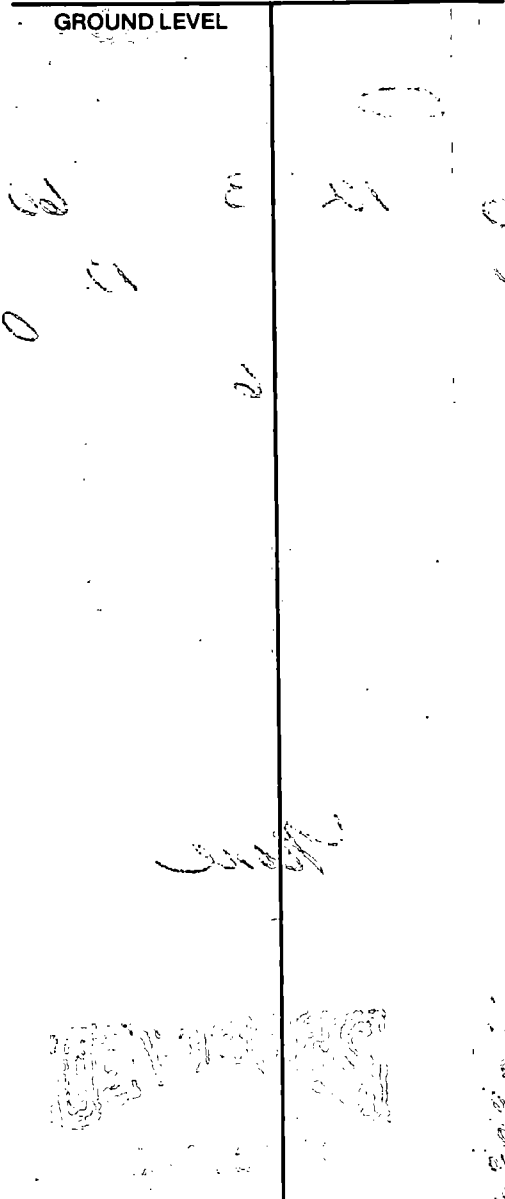

1	2	3	4
5	6	7	8
9	10	11	12
13	14	15	16

SECTION _____

Please indicate well location X.

ADDITIONAL INFORMATION

Handwritten notes and sketches in the additional information section, including a circular diagram and various lines of text.

If more than one screen, show location of each on sketch.