

HARRISON
 D15
 7-10-70

MISSISSIPPI
 BOARD OF WATER COMMISSIONERS
 416 North State Street
 Jackson, Mississippi 39201

CODED

WATER WELL DRILLERS LOG

7/10/70 date well completed
 Coastal Drilling Co. firm name
 county well located

LANDOWNER: *John*
10128
Lawrence
 (mailing address)

description of formations encountered	from	to
top soil	0	3
Blue clay	3	21
white sand	21	37
hard blue clay	37	200
free water zone	200	213
concrete sand	213	242

WELL LOCATION:
 sec 10 T 5 N R 10 E
 S W
De Soto Nat Forest
 (distance) (direction) (nearest town)

WELL PURPOSE: *Home*
 (home, irrigation, municipal, industrial)

WELL COMPLETION DATA:
 (1) diameter (inches) 2"
 (2) total depth (feet) 242
 (3) static water level (feet) 18' below top of ground above
 (4) casing Galv 232
 (material) (depth)
 (size) If telescope see back.
 (5) screen 10' 232
 (length) (depth to top)
2" 25
 (size) (material)
 (6) pump 1HP 18
 (HP) (yield gpm)
Electric
 (type power)
 (7) electric log no
 (yes or no)
no
 (organization running log)

CODED


(8) how well bottom plugged
2" backwash pipe
 DRILLERS REMARKS:
good

AUG 4 1970

MISS. BD. OF
 WATER COMM.

If well telescopes please sketch and show depths.

GROUND LEVEL

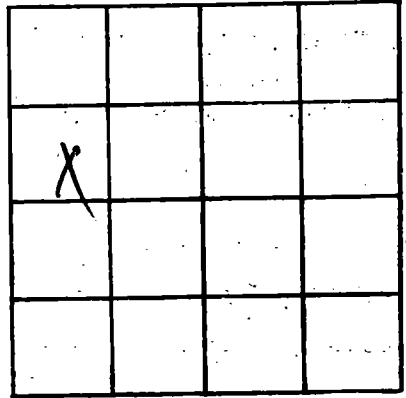

SECTION _____

Please indicate well location X.

ADDITIONAL INFORMATION

If more than one screen, show locations of each on sketch.