

HAR.

DI6

053170

WATER WELL DRILLERS LOG

CODED

8-15-63

C. T. SWITZER WELL CO.

Date: 8-15, 1963, Driller:

County: Harrison

(Name)

(1) Owner of Land: Mark Wilson

(Name)

(Address)

(2) Location: 1/4, 1/4, Sec. 32 T. 4 R. 9

miles of (distance) (direction) (Nearest Town)

(3) Topography: (Hilly) (Flat) (Level)

(4) Purpose of Well: Domestic (Domestic Irrigation, Municipal, Industrial, Other)

Description & Color of Materials Sand, Clay, Red Clay, Shell, etc.

Thick-ness Feet

clay 10-10
sand, silt 10-90

CODED


Information upon completion of well:

- (1) Diameter 2 inches.
(2) Total Depth 90 feet.
(3) Water Level 32' feet below top of ground.
(4) Cased to 90', Size 2"
(5) Screen: Size 2", Length 10'
(6) Were any formations sealed against pollution? yes, no.

If YES depth of formation

Why North East Regional

Drillers Remarks:

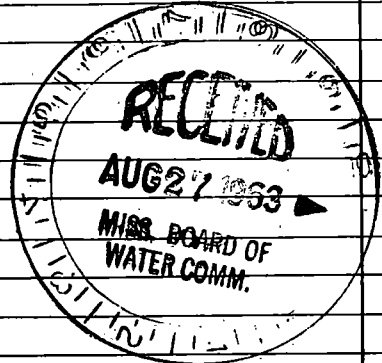

(Use Back Side)

Well No.

COPIED

[Faint, illegible text and markings covering the page]