

**HARRISON**  
**D 25**  
**2-23-73**

MISSISSIPPI  
 BOARD OF WATER COMMISSIONERS  
 416 North State Street  
 Jackson, Mississippi 39201

**CODED**

WATER WELL DRILLERS LOG

2-23 1973 Surigo Well Co. firm name Harrison county well located  
 date well completed

LANDOWNER: L.B. Crabtree  
Pl 1 Bx 95  
Ocean Springs, Miss.  
 (mailing address)

WELL LOCATION:  
 sec. 13 T 5 S R 10 W  
17 miles N of Biloxi  
 (distance) (direction) (nearest town)

WELL PURPOSE:  
 (home, irrigation, municipal, industrial)

WELL COMPLETION DATA:

- (1) diameter (inches) 2"
- (2) total depth (feet) 791'
- (3) static water level (feet) 50' <sup>below</sup> <sub>above</sub> top of ground.
- (4) casing galv. (material) 791' (depth)
- (5) screen 20 (length) 771' (depth to top)  
008 (size) stainless steel (material)
- (6) pump 1 (HP) 10.5 (yield gpm)  
Electr. (type power)
- (7) electric log No (yes or no)  
 (organization running log)


description of formations encountered	from	to
Clay	0	20
sand	20	24
clay	24	87
sand-gravel mix	87	108
sand	108	117
clay	117	129
blue clay	129	150
clay	150	236
clay-sand str.	236	257
clay	257	266
fine sand	266	297
clay	297	319
sand	319	321
clay-sand mixed	321	342
clay	342	412
fine sand	412	425
fine sand	425	431
clay	431	493
clay-sand str.	493	514
clay	514	571
fine sand	571	576
clay	576	598
clay-sand str.	598	619
clay	619	633
fine sand	633	662
fine sand-clay	662	684
clay	684	691
fine sand	691	706
sand-clay	706	727
fine sand	727	752
good sand	752	791

(8) how well bottom plugged Back  
pressure valve

DRILLERS REMARKS:

If well telescopes please sketch and show depths.

GROUND LEVEL

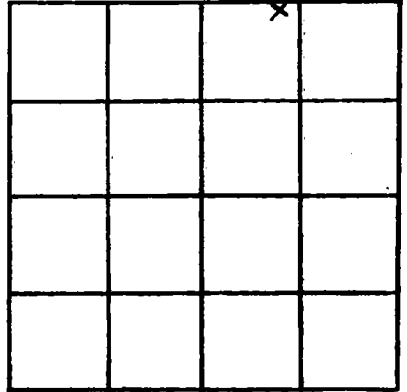

SECTION 13

Please indicate well location X.

ADDITIONAL INFORMATION

If more than one screen, show locations of each on sketch.