

Harrison
D 26
7-8-73

MISSISSIPPI
BOARD OF WATER COMMISSIONERS
416 North State Street
Jackson, Mississippi 39201

CODED

WATER WELL DRILLERS LOG

7/8 1973 COASTAL DRILLING & SERVICE CO. *Harrison*
date well completed ROUTE 1 BOX 618 county well located

LANDOWNER: *L.W. Biloxi, Miss*
Porter Rt 6 Box 770
Biloxi, Miss
(mailing address)

WELL LOCATION:
see *33 T S R 10 E*
(2) 1/2 miles *NE* of *Hwy 67*
(distance) (direction) (nearest town)

WELL PURPOSE: *Home*
(home, irrigation, municipal, industrial)

WELL COMPLETION DATA:

- (1) diameter (inches) 4"
- (2) total depth (feet) 705'
- (3) static water level (feet) 72' below above top of ground.
- (4) casing galv, 675'
(material) (depth)
- (5) screen 30', 675'
(length) (depth to top)
- 4", S.S.
(size) (material)
- (6) pump 3 Hp, 53
(HP) (yield gpm)
- 5 hp
(type power)
- (7) electric log no
(yes or no)

(organization running log)

(8) how well bottom plugged 4" backwash valve

DRILLERS REMARKS:
Very good well

Description of formations encountered	from	to
<i>Top Soil</i>	<i>1</i>	<i>3</i>
<i>Red Clay</i>	<i>3</i>	<i>9</i>
<i>White Sand</i>	<i>9</i>	<i>25</i>
<i>Sugar Sand</i>	<i>25</i>	<i>50</i>
<i>White Sand</i>	<i>50</i>	<i>105</i>
<i>Soft Blue Clay</i>	<i>105</i>	<i>200</i>
<i>Hard Blue Clay</i>	<i>200</i>	<i>340</i>
<i>fine waty sand</i>	<i>340</i>	<i>365</i>
<i>Coarse wate sand</i>	<i>365</i>	<i>400</i>
<i>Rock</i>	<i>400</i>	<i>401</i>
<i>very Hard Blue Clay</i>	<i>401</i>	<i>605</i>
<i>fine waty Sand</i>	<i>605</i>	<i>615</i>
<i>fine waty Sand</i>	<i>615</i>	<i>635</i>
<i>Coarse wate Sand</i>	<i>635</i>	<i>705</i>


CODED

SEP 7 1973

Mississippi
WATER COMMISSION

If well telescopes please sketch and show depths.

GROUND LEVEL

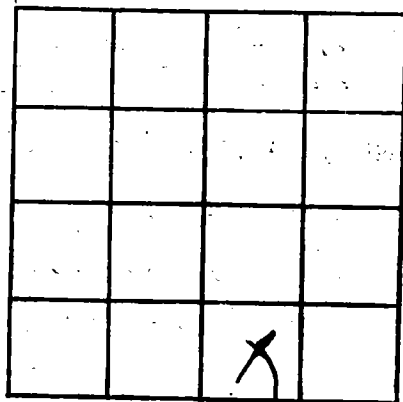

SECTION _____

Please indicate well location X.

ADDITIONAL INFORMATION

If more than one screen,
show locations of each on sketch.