

HARRISON

D 28

MISSISSIPPI
BOARD OF WATER COMMISSIONERS
416 North State Street
Jackson, Mississippi 39201

WATER WELL DRILLERS LOG

5-18-73

May 18 1973 Mc Hill Well Works Harrison
date well completed firm name county well located

LANDOWNER: Tala Solcia

description of formations encountered

from to

Hwy 67
 Gulfport Miss
(mailing address)

Clay 0 50
Sand 50 87
bleach 87 168
Blue clay 168 256
fine sand 256 315
clay 315 371
slush 371 410
sand 410 447

WELL LOCATION:

sec. 6 T. 5 N R. 9 E
S W
26 miles SE. of Lucier
(distance) (direction) (nearest town)

WELL PURPOSE: Home
(home, irrigation, municipal, industrial)

WELL COMPLETION DATA:

- (1) diameter (inches) 2"
- (2) total depth (feet) 447'
- (3) static water level (feet) 110' ^{below} / above top of ground
- (4) casing plastic 4.37'
(material) (depth)
- (size) If telescope see back.
- (5) screen 10' —
(length) (depth to top)
- 2" plastic
(size) (material)
- (6) pump 2" 4
(HP) (yield gpm)
- electric
(type power)
- (7) electric log no
(yes or no)
- (organization running log)
- (8) how well bottom plugged sand
sharp


CODED

MISS. REG. 3-1-73

DRILLERS REMARKS:

If well telescopes please sketch and show depths.

GROUND LEVEL

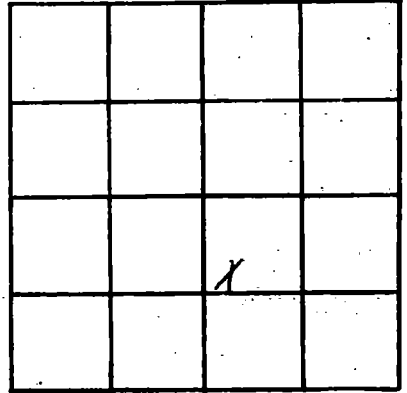

SECTION 6

Please indicate well location X.

ADDITIONAL INFORMATION

If more than one screen, show locations of each on sketch.