

HARRISON
D 30

1174

MISSISSIPPI
BOARD OF WATER COMMISSIONERS
416 North State Street
Jackson, Mississippi 39201

WATER WELL DRILLERS LOG

Bryant Well Co Harrison

date well completed

firm name

county well located

LANDOWNER: Little DEER Lodge
RAMSEY Rd
SANGIER, Ms.
(mailing address)

description of formations encountered	from	to
RED CLAY	0	23
SAND	23	33
CLAY	33	43
SAND	43	80


WELL LOCATION:
sec 31 T 4 S R 9 W
15 miles N of Biloxi
(distance) (direction) (nearest town)

WELL PURPOSE: CAMP
(home, irrigation, municipal, industrial)

WELL COMPLETION DATA:

- (1) diameter (inches) 2
- (2) total depth (feet) 80
- (3) static water level (feet) 19 - below top of ground
- (4) casing PVC 70 (material) (depth)
(size) If telescope see back.
- (5) screen 10 70 (length) (depth to top)
204 PVC (size) (material)
- (6) pump 1/2 8 (HP) (yield gpm)
ELECT (type power)
- (7) electric log NO (yes or no)
(organization running log)
- (8) how well bottom plugged METAL BACK WASH VALVE

CODED

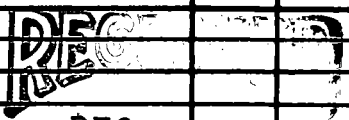

DEC 16 1974

MISS. BD. OF WATER COMM

DRILLERS REMARKS:

If well telescopes please sketch and show depths.

GROUND LEVEL

			X

SECTION 31

Please indicate well location X.

ADDITIONAL INFORMATION

If more than one screen, show locations of each on sketch.