

HARRISON
D31
10-8-74

MISSISSIPPI
BOARD OF WATER COMMISSIONERS
416 North State Street
Jackson, Mississippi 39201

CODED

WATER WELL DRILLERS LOG

Oct. 8 1974 McGill Well Works Harrison
date well completed firm name county well located

LANDOWNER:
Donald C. Lyons
Rt. 1 Box 102
Saucier, Miss (mailing address)
WELL LOCATION:
sec 16 T 5 N R 10 E
4 1/2 miles S.E. of Saucier
(distance) (direction) (nearest town)

| description of formations encountered | from | to |
|---------------------------------------|------|-----|
| Clay | 0 | 61 |
| Slush | 61 | 104 |
| fine sand | 104 | 166 |
| Blue clay | 166 | 238 |
| Slush | 238 | 251 |
| Blue clay | 251 | 278 |
| Concrete | 278 | 300 |


WELL PURPOSE:
(home, irrigation, municipal, industrial)

WELL COMPLETION DATA:
(1) diameter (inches) 2 1/2
(2) total depth (feet) 300 ft.
(3) static water level (feet) 58 below above
top of ground.
(4) casing PVC 290
(material) (depth)
2 1/2 If telescope see back.
(size)
(5) screen 10' 290
(length) (depth to top)
2 1/2 S.S.
(size) (material)
(6) pump 1 10
(HP) (yield gpm)
electric
(type power)
(7) electric log NO
(yes or no)

(organization running log)
(8) how well bottom plugged and stark
back wash water

DRILLERS REMARKS:


CODED

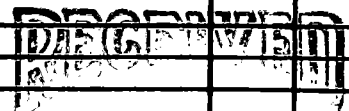

JAN 21 1975

If well telescopes please sketch and show depths.

GROUND LEVEL

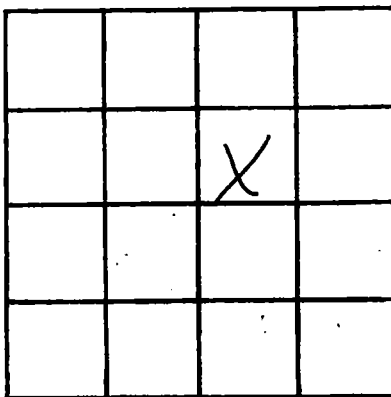

SECTION 16

Please indicate well location X.

ADDITIONAL INFORMATION

If more than one screen, show locations of each on sketch.