

MISSISSIPPI DEPARTMENT OF NATURAL RESOURCES

Bureau of Land and Water Resources

Southport Mall

P.O. Box 10631

Jackson, Mississippi 39209 **CODED**

WATER WELL DRILLERS LOG

HARRISON  
D-532  
05-26-82  
5-26

date well completed

19 82 Broden Pump & Well Co.  
firm name

county well located Harrison

| LANDOWNER:  | description of formations encountered | from       | to         |
|---|---------------------------------------|------------|------------|
| <u>J. L. Seymour</u>  | <u>Clay</u>                           | <u>0</u>   | <u>20</u>  |
| <u>RR 1 Box 158 - Ocean Springs</u><br>(mailing address)                                | <u>Sand</u>                           | <u>20</u>  | <u>60</u>  |
|   | <u>Clay - white</u>                   | <u>60</u>  | <u>140</u> |
|   | <u>Sand</u>                           | <u>140</u> | <u>160</u> |
| WELL LOCATION:  | <u>Gray Clay</u> <b>CODED</b>         | <u>160</u> | <u>195</u> |
| sec. <u>2</u> T. <u>5</u> S. R. <u>9</u> E. W.  | <u>Sand</u>                           | <u>195</u> | <u>200</u> |
| <u>10</u> miles <u>N</u> of <u>Andersville</u><br>(distance) (direction) (nearest town) | <u>Blue Clay</u>                      | <u>200</u> | <u>260</u> |
|   | <u>Sand</u>                           | <u>260</u> | <u>270</u> |
| WELL PURPOSE: <u>Home</u><br>(home, irrigation, municipal, industrial)                  | <u>Blue Clay</u>                      | <u>270</u> | <u>490</u> |
|   | <u>Sand</u>                           | <u>490</u> | <u>500</u> |
| WELL COMPLETION DATA:   | <u>Blue Clay</u>                      | <u>500</u> | <u>730</u> |
| (1) diameter (inches) <u>2"</u>   | <u>Gray Sand</u>                      | <u>730</u> | <u>760</u> |
| (2) total depth (feet) <u>760</u>   |                                       |            |            |
| (3) static water level (feet) <u>38'</u> below above top of ground.                     |                                       |            |            |
| (4) casing <u>PVC</u> , <u>740</u><br>(material) (depth)                                |                                       |            |            |
| <u>2"</u><br>(size) if telescope see back.  |                                       |            |            |
| (5) screen <u>10ft</u> , <u>740</u><br>(length) (depth to top)                          | <u>Elevation: 78 feet</u>             |            |            |
| <u>2"</u> , <u>PVC</u> , <u>008</u><br>(size) (material)                                | <u>0885307303546</u>                  |            |            |
| (6) pump <u>1</u> , <u>10</u><br>(HP) (yield gpm)                                       |                                       |            |            |
| <u>220V-80</u><br>(type power)  |                                       |            |            |
| (7) electric log <u>No.</u><br>(yes or no)  |                                       |            |            |
| (organization running log)  |                                       |            |            |
| (8) how well bottom plugged <u>24 Sand shot</u>   |                                       |            |            |
| DRILLERS REMARKS:<br><u>No Tail Pipe</u>  |                                       |            |            |


DEPT. OF NATURAL RESOURCES  
BUREAU OF LAND & WATER RESOURCES

JUN 28 1982

**RECEIVED**

If well telescopes please sketch and show depths.

GROUND LEVEL

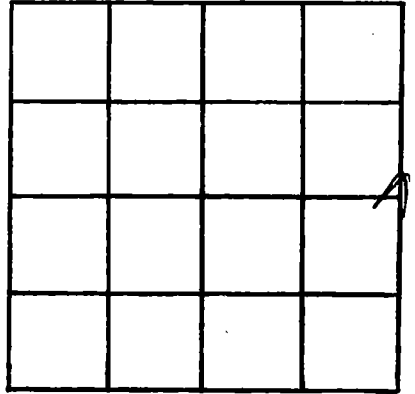

SECTION 21

Please indicate well location X.

ADDITIONAL INFORMATION

If more than one screen,  
show locations of each on sketch.