

MISSISSIPPI DEPARTMENT OF NATURAL RESOURCES
Bureau of Land and Water Resources
 Southport Mall
 P.O. Box 10631
 Jackson, Mississippi 39209
WATER WELL DRILLERS LOG

HARRISON
D 33
11/5/82

11-5-82 19
 date well completed

Lyman Well Co.
 firm name

Harrison
 county well located

LANDOWNER: Arlen D. Monroe
16208
Race Track Rd Biloxi
 (mailing address) 39532

description of formations encountered	from	to
<u>White sand</u>	<u>0</u>	<u>60</u>
<u>Blue clay</u>	<u>60</u>	<u>200</u>
<u>Gray sand</u>	<u>200</u>	<u>260</u>
<u>Blue clay</u>	<u>260</u>	<u>300</u>
<u>Good sand</u>	<u>300</u>	<u>360</u>

WELL LOCATION:
 sec. 9 T. 5 N. R. 9 E
 (S) (W)
0 miles 0 of Biloxie
 (distance) (direction) (nearest town)

WELL PURPOSE: Home
 (home, irrigation, municipal, industrial)

- WELL COMPLETION DATA:
- (1) diameter (inches) 2"
 - (2) total depth (feet) 360'
 - (3) static water level (feet) 9' ^{below} above top of ground.
 - (4) casing PVC, 360'
 (material) (depth)
2"
 (size) if telescope see back.
 - (5) screen 10', 360'
 (length) (depth to top)
2", PVC
 (size) (material)
 - (6) pump 1/2, 20
 (HP) (yield gpm)
Elect
 (type power)
 - (7) electric log NO
 (yes or no)
NO
 (organization running log)
 - (8) how well bottom plugged Sand
Shark

CODED

DEPT. OF NATURAL RESOURCES
 BUREAU OF LAND & WATER RESOURCES


FEB 25 1983

RECEIVED

DRILLERS REMARKS:

If well telescopes please sketch and show depths.

GROUND LEVEL

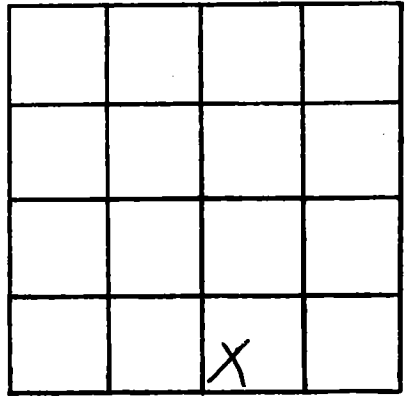

SECTION 9

Please indicate well location X.

ADDITIONAL INFORMATION

If more than one screen, show locations of each on sketch.