

MISSISSIPPI DEPARTMENT OF NATURAL RESOURCES

Bureau of Land and Water Resources

Southport Mall

P.O. Box 10631

Jackson, Mississippi 39209

WATER WELL DRILLERS LOG

HARRISON
D35
12-2-83

CODED

Dec. 2, 1983 *Duncan Well Drilling Harrison*
date well completed firm name county well located

LANDOWNER: *Brenda Mann*
2882 Oriah Hill Dr.
Biloxi, Ms. 39531
(mailing address)

description of formations encountered	from	to
<i>Top sand</i>	<i>0</i>	<i>10</i>
<i>blue clay</i>	<i>10</i>	<i>75</i>
<i>sand</i>	<i>75</i>	<i>100</i>

WELL LOCATION:
sec *24* T *5* N R *10* E
2 miles *S.E.* of *Lancaster*
(distance) (direction) (nearest town)

WELL PURPOSE: *Home*
(home, irrigation, municipal, industrial)

WELL COMPLETION DATA:

(1) diameter (inches) *2"*

(2) total depth (feet) *100 ft.*

(3) static water level (feet) *20* ^{below} / _{above} top of ground.

(4) casing *PVC* *90'*
(material) (depth)

— (size) if telescope see back.

(5) screen *10'* *90'*
(length) (depth to top)

2" *PVC*
(size) (material)

(6) pump *1* *8*
(HP) (yield gpm)

electric
(type power)

(7) electric log *—*
(yes or no)

DEPT. OF NATURAL RESOURCES
BUREAU OF LAND & WATER RESOURCES

FEB 21 1984

RECEIVED


(organization running log)

(8) how well bottom plugged *Sand*
Mark

DRILLERS REMARKS:

If well telescopes please sketch and show depths.

GROUND LEVEL

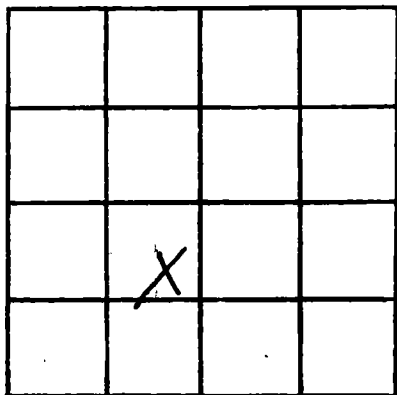

SECTION _____

Please indicate well location X.

ADDITIONAL INFORMATION

If more than one screen, show locations of each on sketch.