

**MISSISSIPPI DEPARTMENT OF ENVIRONMENTAL QUALITY**

Office of Land and Water Resources

P. O. Box 10631  
Jackson, MS 39289-0631  
**WATER WELL DRILLERS LOG**

COUNTY WELL LOCATED <i>Harrison</i>	
WELL NUMBER <i>D-56</i>	CODED
DATE WELL COMPLETED <i>Dec 27, 02</i>	

PERMIT NUMBER <i>M+W well</i>
NAME OF DRILLING FIRM <i>8827 BOSS NUGLY</i>
<i>BiLoxi</i>

NAME & MAILING ADDRESS OF LANDOWNER  
*Fred Hood*  
*23152 Ina Johnson*  
*Lynn*

Latitude:  
Longitude:

WELL LOCATION: SEC 7 TOWNSHIP N 10 E RANGE 10

DISTANCE 1 Miles DIRECTION North of NEAREST TOWN Harrison

OTHER LANDMARK  
*1/4 mile from Fire Dept*

WELL PURPOSE: Home, Irrigation, Municipal, Industrial, Fish Pond, etc.  
*Home*

**PUMP DATA**

PUMP TYPE (Circle One):  
 Submersible     Turbine     Jet     Flowing Well,  
Other (Describe) \_\_\_\_\_

POWER TYPE (Circle One):  
 Electric     Tractor, Diesel, Gasoline, Butane,  
Other (Describe) \_\_\_\_\_ H/P \_\_\_\_\_

DESCRIPTION OF FORMATIONS ENCOUNTERED	FROM	TO
<i>Top soil</i>	<i>1</i>	<i>7</i>
<i>Dark clay</i>	<i>7</i>	<i>35</i>
<i>sand &amp; gravel</i>	<i>35</i>	<i>55</i>
<i>white clay</i>	<i>55</i>	<i>80</i>
<i>gray clay</i>	<i>80</i>	<i>180</i>
<i>green clay</i>	<i>180</i>	<i>260</i>
<i>Sand</i>	<i>260</i>	<i>380</i>

**WELL DATA**

Well Depth <i>380</i>	Casing Diameter (In.) <i>4"</i>	Casing Length (Ft.) <i>370</i>
--------------------------	------------------------------------	-----------------------------------

Type of Casing <i>PVC</i>	Hole Depth <i>380</i>	Depth to Static Water Level <i>130</i>
------------------------------	--------------------------	---

TYPE OF COMPLETION: (Circle One or More):  
 Gravel Packed,     Underreamed,     Telescoped,  
 Natural Development,     Open Hole,     Other  
(Describe) \_\_\_\_\_

WELL GROUTED TO A DEPTH OF 11 FEET  
Type Grout (circle one): Cement, Bentonite, or Mix

**SCREEN DATA**

Diameter - Inches <i>4</i>	Length - Feet <i>10</i>	Slot Size - Inches <i>.006</i>
-------------------------------	----------------------------	-----------------------------------

Screen Type <i>PVC</i>	Depth to Bottom - Feet <i>370-380</i>
---------------------------	--

**RECEIVED**

**FEB 10 2003**

**BY: OLWR**

Top of Lap Pipe or Reduction in Casing

FEET  IF TELESCOPED OR MORE THAN ONE SCREEN: USE BACK PAGE

I certify that the well was drilled, constructed and completed in accordance with all applicable Requirements of the Mississippi Department of Environmental Quality and/or the Mississippi Department of Health regulations and state laws.


*Ale Mould* 0563  
Signature of Licensed Driller and License No.

*Feb 6, 03*  
Date

Additional Information Required On Back

If well telescopes please sketch and show depths.

GROUND LEVEL

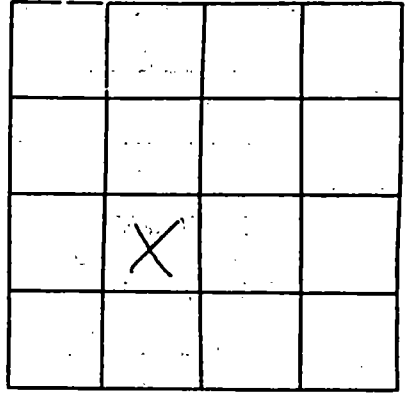

SECTION 7

Please indicate well location X.

Pump Capacity (GPM)	No. of Stages	Setting Depth
<u>15</u>	<u>13</u>	<u>150</u> FT.

PUMP TEST

Well yielded 25 GPM with  
a drawdown of 140 ft.  
after \_\_\_\_\_ hours of pumping

LOG DATA

TYPE OF LOG RUN (Circle One): No Log Run, Electric, Gamma Ray, Density, Sonic, Neutron, Other (Describe) \_\_\_\_\_

Name of Organization Running Log \_\_\_\_\_

GEOLOGIC DATA (Office Use Only)

Surface Elev.	Geologic Unit	Unit Thickness	Depth to Top
Subs. SWL	Date	Analysis	Aquifer Test

Driller's Remarks

\_\_\_\_\_  
\_\_\_\_\_  
\_\_\_\_\_  
\_\_\_\_\_

If more than one screen, show location of each on sketch.