*
County: Harrison
Permit #;
Drille <u>ABSTWATER WELLSRV.</u>
Date drilling completed: 4-28-10

State Well Report

Part 1

Mississippi Department of Environmental Quality
Office of Land and Water Resources
P.O. Box 10631
Jackson, MS 39289-0631

(601) 961-5210 (601) 354-6938 (fax)

For Office Use Only:		
Aquifer: 90		
Well #:		
L. S. Elevation:		
E-log #:		

State Law requires that this report be prepared by the driller in detail and filed with the Department within 30 days of completion of drilling of the well.


Well Owner Information Owner Name CULTIC Colored Conventional Survey, City State Zip Code Telephone No. City State Zip Code City Cit		
Method of Lav/Long (circle one): Conventional Survey, Well Data Purpose of Well (circle one): Money Industrial Public Supply Irrigation Fish Culture Other: Date well drilling started: 4-8-10 If flowing, method of flow regulation: Valve Method of Measurement (circle one) steel tape electric tape Method of Measurement (circle one) steel tape electric tape Method of Measurement (circle one) Steel tape Method of Measurement (circle one) Industrial Public Supply Method of Measurement (circle one) Industrial Public Supply Method of Measurement (circle one) Method of Measurement (circle one) Method of Measurement (circle one) Industrial Public Supply Method of Measurement (circle one) Method of Lav/Long (circle one) Method of Lav/Long (circle one) Method of Measurement (circle one) Method		
Mailing Address: 3 1 C 3 C Mackwell Farms Kol Bill X		
Bilexi Ms State Zip Code Telephone No. 2005 File 33 GC Well Data Well Data Purpose of Well (circle one) Home Industrial Public Supply Irrigation Fish Culture Other: Date well drilling started: 438-10 If flowing, method of flow regulation: Valve N/A Other (describe) Static Water Level: 130 feet above or below (circle one) land surface Date measured: 438-10 Method of Measurement (circle one) steel tape electric tape air line other: Hole depth: 333 FT Well depth: 333 FT Well grouted to a depth of 10 feet Type of grout (circle one): Cernent Bentonite) Mix Casing length: 15 feet Screen diameter:		
Telephone No. 2005 5716 - 3357 C Well Data Purpose of Well (circle one) Home Industrial Public Supply Irrigation Fish Culture Other: Date well drilling started: 4-38-10 Date well drilling completed: 4-38-10 If flowing, method of flow regulation: Valve N/A Other (describe) Static Water Level: 100 feet above or felow (circle one) land surface Date measured: 4-38-10 Method of Measurement (circle one) steel tape electric tape air line other: Hole depth: 323 FT. Well depth: 323 FT. Well grouted to a depth of 10 feet Type of grout (circle one): Cement Bentonite) Mix Casing length: 15 feet Casing diameter: a inches Type of casing: PVC Screen length: 15 feet Screen diameter: a inches Type of screen: PVC Screen slot size: 0006 inches Setting depth: From 308 feet to 323 feet Type of completion (circle all applicable): Gravel packed Underreamed Telescoped Open hole Natural Development Other (describe): Top of lap pipe or reduction in casing: M/A feet. If telescoped or more than one screen, describe on back of page		
Distance Distance Direction Nearest Town Miles Miles Miles Direction Miles		
Purpose of Well (circle one) Home Industrial Public Supply Irrigation Fish Culture Other: Date well drilling started: 4-8-10 Date well drilling completed: 4-8-10 If flowing, method of flow regulation: Valve N/A Other (describe) Static Water Level: 100 feet above or below (circle one) land surface Date measured: 4-8-10 Method of Measurement (circle one) steel tape electric tape air line other: Hole depth: 3-3-17. Well depth: 3-3-17. Well grouted to a depth of 10 feet Type of grout (circle one): Cement Bentonite Mix Casing length: 3-68 feet Casing diameter: a inches Type of casing: PVC Screen length: 15 feet Screen diameter: a inches Type of screen: PVC Screen slot size: 000 inches Setting depth: From 308 feet to 323 feet Type of completion (circle all applicable): Gravel packed Underreamed Telescoped Open hole Natural Development Other (describe): Top of lap pipe or reduction in casing: N/A feet. If telescoped or more than one screen, describe on back of page		
Purpose of Well (circle one) Home Industrial Public Supply Irrigation Fish Culture Other: Date well drilling started: 4-8-10 Date well drilling completed: 4-8-10 If flowing, method of flow regulation: Valve N/A Other (describe) Static Water Level: 100 feet above or below (circle one) land surface Date measured: 4-8-10 Method of Measurement (circle one) steel tape electric tape air line other: Hole depth: 3-3-17. Well depth: 3-3-17. Well grouted to a depth of 10 feet Type of grout (circle one): Cement Bentonite Mix Casing length: 3-68 feet Casing diameter: a inches Type of casing: PVC Screen length: 15 feet Screen diameter: a inches Type of screen: PVC Screen slot size: 000 inches Setting depth: From 308 feet to 323 feet Type of completion (circle all applicable): Gravel packed Underreamed Telescoped Open hole Natural Development Other (describe): Top of lap pipe or reduction in casing: N/A feet. If telescoped or more than one screen, describe on back of page		
Date well drilling started: 4-8-10 Date well drilling completed: 4-8-10 If flowing, method of flow regulation: Valve N/A Other (describe) Static Water Level: 120 feet above or below (circle one) land surface Date measured: 4-8-10 Method of Measurement (circle one) steel tape electric tape air line other: Hole depth: 323 FT. Well depth: 33 FT Well grouted to a depth of 10 feet Type of grout (circle one): Cement Bentonite Mix Casing length: 368 feet Casing diameter: 2 inches Type of casing: PVC Screen length: 15 feet Screen diameter: 308 feet to 323 feet Type of completion (circle all applicable): Gravel packed Underreamed Telescoped Open hole Natural Development Other (describe): Top of lap pipe or reduction in casing: N/A feet. If telescoped or more than one screen, describe on back of page		
Static Water Level:		
Static Water Level:		
Method of Measurement (circle one) steel tape electric tape air line other: Hole depth: 333 FT. Well depth: 33 FT. Well grouted to a depth of 10 feet Type of grout (circle one): Cement Bentonite) Mix Casing length: 368 feet Casing diameter: inches Type of casing: PVC Screen length: 15 feet Screen diameter: inches Type of screen: PVC Screen slot size: 006 inches Setting depth: From 308 feet to 323 feet Type of completion (circle all applicable): Gravel packed Underreamed Telescoped Open hole Natural Development Other (describe): Top of lap pipe or reduction in casing: NA feet. If telescoped or more than one screen, describe on back of page		
Hole depth: 333 FT. Well depth: 333 FT Well grouted to a depth of 10 feet Type of grout (circle one): Cement Bentonite) Mix Casing length: 368 feet Casing diameter:		
Type of grout (circle one): Cement Bentonite) Mix Casing length: 368 feet Casing diameter:		
Casing length: 368 feet Casing diameter:		
Screen length:		
Screen slot size: inches Setting depth: From 308 feet to feet Type of completion (circle all applicable): Gravel packed Underreamed Telescoped Open hole Natural Development Other (describe): Top of lap pipe or reduction in casing: feet. If telescoped or more than one screen, describe on back of page		
Type of completion (circle all applicable): Gravel packed Underreamed Telescoped Open hole Natural Development Other (describe): Top of lap pipe or reduction in casing: feet. If telescoped or more than one screen, describe on back of page		
Other (describe): Top of lap pipe or reduction in casing: feet. If telescoped or more than one screen, describe on back of page		
Top of lap pipe or reduction in casing: feet. If telescoped or more than one screen, describe on back of page		
Top of lap pipe or reduction in casing: feet. If telescoped or more than one screen, describe on back of page		
Logs run (circle all applicable): No log run Electric Gamma Ray Density Sonic Neutron Other:		
Name of organization running log(s):		
I certify that the well was drilled, constructed, and completed in accordance with all applicable requirements of the Mississippi		
Department of Environmental Quality and/or the Mississippi Department of Health regulations and state laws.		
Jack Ridgell 0-472 Que Rilder		
Print Name of Water Well Contractor and License No. Signature of Water Well Contractor		

If well telescopes please sketch below and show depths.

Ground Level			

Description of Formations Encountered	From	To
Topsoil	C	3
orange Clay	Q	10
orange Coarke Sand		23
manot Clay	33	75
Blue Clay W /Streaks Of Sand	75	988
Gray Coatse Earld	288	33.3
	<u> </u>	L

If more than one screen, show location of each on sketch

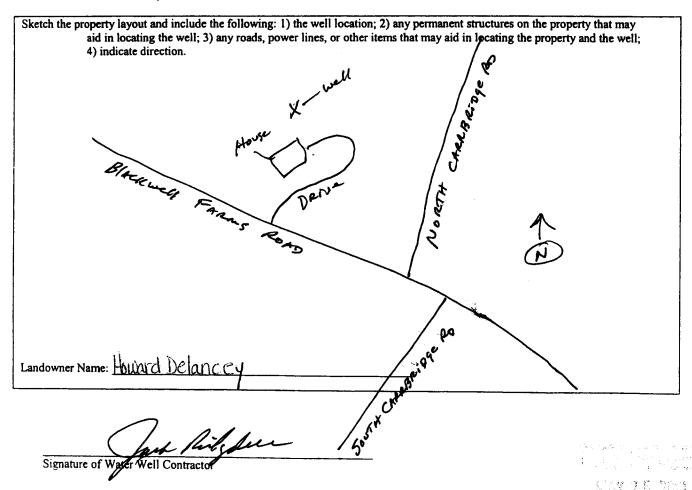

D	9	Ü
---	---	---

STATE WELL REPORT Part 2

Date completed:

Pump Installer's Completion Report Mississippi Department of Environmental Quality Office of Land and Water Resources P.O. Box 10631

Jackson, MS 39289-0631 (601) 961-5210 (601) 354-6938 (fax)

For Office Use Only:	_
Aquifer:	
Well #:	
Elevation:	

This report should be prepared by the pump installer in detail and filed with the Department within 30 days of the installation of pump. Well Owner Information Well Location Longitude Method of Lat/Long (circle one): Conventional Survey, Mailing Address: 610 USGS quad, Hand-held GPS, Survey-grade GPS NE 1/4 SE 1/4 Sec 28 Twn 755 Rng R10 W Nearest Town Distance Direction Telephone No. 208 596-3390 Miles NORTH of Biloxi Power Type Pump Type Circle one Circle one Gasoline Engine Natural Gas Submersible Diesel Engine Air Lift Electric Motor Hand Tractor PTO Turbine Bucket Piston Flowing Well Windmill Other (specify): Centrifugal Rotary Horse Power Rating of Motor: 3 Other (specify): Setting Depth: 14 Date Pump Installed: Gallons Per Minute Rated Pump Capacity: Number of Stages: Pump Test Data Method of Measuring Water Level Circle one Date Well Tested: Air Line Electric Measuring Line Steel Tape Static Water Level (A): Feet Below Land Surface Other (specify): Pumping Water Level (B): Feet Below Land Surface Drawdown [(B) - (A)]: Feet Below Land Surface For flowing well, measured shut in head: Gallons Per Minute Test Pumping Rate: GPM with a drawdown of Duration of Pump Test (minimum 4 hours): hours of pumping

I HEREBY CERTIFY that the above statements are true to the best of	f my knowledge.	and the first of the second
Print Name of Pump Installer and License No. (if applicable)	Signature of Pump Installer	7447 7 1 25.J