

HARRISON
D 2000
11-12-75

MISSISSIPPI
BOARD OF WATER COMMISSIONERS
416 North State Street
Jackson, Mississippi 39201

WATER WELL DRILLERS LOG

11/12 19 75 COASTAL DRILLING & SERVICE CO. Harrison
date well completed firm name county well located

ROUTE 1 BOX 618

LANDOWNER: Dennis Moore BILEAU MISSISSIPPI 39532
encountered

RT 2 Box 237A
Sancius Mini (mailing address)

WELL LOCATION:
sec 6 T 5 N R 9 E S W
3/4 mi S of S. Lumb. Ave. R. 1 mi E of S. Lumb. Ave. R. 1 mi W of S. Lumb. Ave. R.

WELL PURPOSE: home
(home, irrigation, municipal, industrial)


WELL COMPLETION DATA:

- (1) diameter (inches) 2"
- (2) total depth (feet) 277
- (3) static water level (feet) 40 below top of ground
- (4) casing PVC 267' (material) (depth)
- (5) screen 10' 267' (length) (depth to top)
2" PVC (size) (material)
- (6) pump One 10 (HP) (yield gpm)
Ele (type power)
- (7) electric log no (yes or no)

(8) how well bottom plugged
Structural Value

DRILLERS REMARKS:
none


	from	to
Top Soil	1	3
Red Clay	3	15
White Sand	15	40
Sugar Sand	40	65
hard blue	65	200
fine water sand	200	225
Coarse water sand	225	277

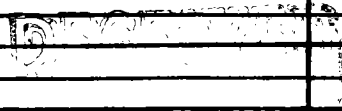

FEB 1 1978

If well telescopes please sketch and show depths.

GROUND LEVEL

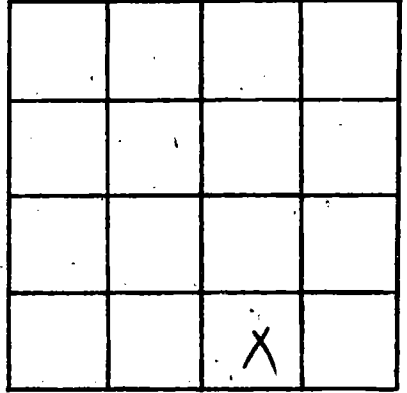

SECTION _____

Please indicate well location X.

ADDITIONAL INFORMATION

A series of horizontal lines for writing additional information.

If more than one screen, show locations of each on sketch.