

HARRISON  
D 2002  
2-14-76

MISSISSIPPI  
BOARD OF WATER COMMISSIONERS  
416 North State Street  
Jackson, Mississippi 39201

COASTAL DRILLING & SERVICE CO.

ROUTE 1 BOX 618  
BILOXI, MISS. 39532

Harrison  
county well located

2/14/76  
date well completed

LANDOWNERS: George J. Adams  
Rt 1 Box 770  
Biloxi, Miss  
(mailing address)

description of formations encountered	from	to
Top Soil	1	3
Red Clay	3	18
white sand	18	35
Soft Blue Clay	35	90
Hard Blue Clay	90	230
fine water sand	230	260
coarse water sand	260	285

WELL LOCATION:  
sec 34 T 5 N R 10 E  
S W  
Wester Creek  
miles (distance) of (direction) (nearest town)

WELL PURPOSE: none  
(home, irrigation, municipal, industrial)

- WELL COMPLETION DATA:
- (1) diameter (inches) 2"
  - (2) total depth (feet) 285'
  - (3) static water level (feet) 90 below top of ground
  - (4) casing PVC, 225'  
(material) (depth)
  - (size) If telescope see back.
  - (5) screen 10' 225'  
(length) (depth to top)
  - 2" PVC  
(size) (material)
  - (6) pump One 15  
(HP) (yield gpm)
  - Ele  
(type power)
  - (7) electric log no  
(yes or no)
  - (organization running log)


(8) how well bottom plugged  
2" sand/water

DRILLERS REMARKS:  
none

RECEIVED  
MAR 25 1976

If well telescopes please sketch and show depths.

GROUND LEVEL

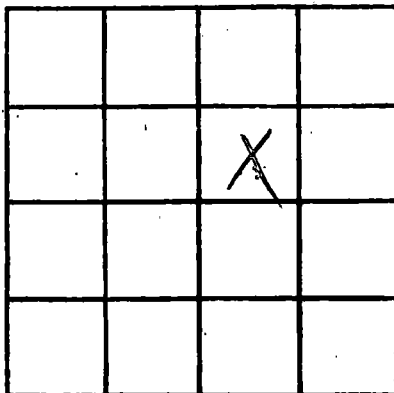

SECTION \_\_\_\_\_

Please indicate well location X.

ADDITIONAL INFORMATION

If more than one screen, show locations of each on sketch.