

HARRISON
D 2007
9-15-77

MISSISSIPPI
BOARD OF WATER COMMISSIONERS
416 North State Street
Jackson, Mississippi 39201

WATER WELL DRILLERS LOG

9-15-1977 date well completed
Parnell Anderson Harrison firm name
Harrison county well located

LANDOWNER:
Manuel Perez
(mailing address)

description of formations encountered	from	to
Top Soil	0	3
Red Clay	3	18
Thin Sand & Clay	18	90
Coarse Sand	90	98

WELL LOCATION:
sec. 21 T. 5 S. R. 10 E.
10 miles SE of Double
(distance) (direction) (nearest town)

WELL PURPOSE: HOME
(home, irrigation, municipal, industrial)

WELL COMPLETION DATA:

(1) diameter (inches) 2"

(2) total depth (feet) 98'

(3) static water level (feet) 12' below top of ground.

(4) casing Plastic, 93'
(material) (depth)
(size) If telescope see back.

(5) screen 5" 93'
(length) (depth to top)
2" Plastic
(size) (material)

(6) pump 1 (HP) 12 (yield gpm)
Elect
(type power)

(7) electric log No
(yes or no)

(organization running log)


(8) how well bottom plugged
Capped

DRILLERS REMARKS:

RECEIVED
NOV - 8 1977

If well telescopes please sketch and show depths.

GROUND LEVEL

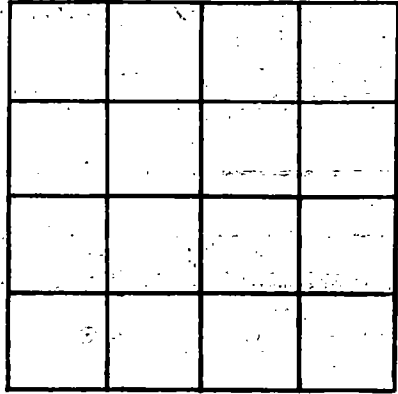

SECTION _____

Please indicate well location X.

ADDITIONAL INFORMATION

If more than one screen, show locations of each on sketch.