

If well telescopes please sketch and show depths.

GROUND LEVEL

4" sch 40
PVC


140'

2" sch 40

150'

160'

100% PVC
underbar

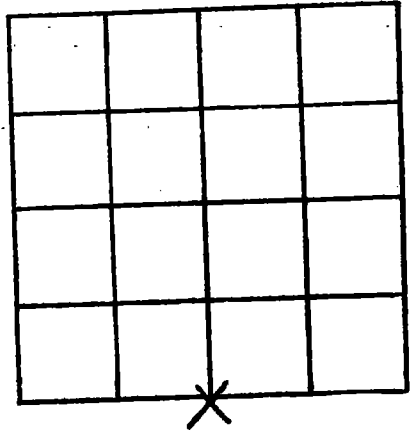

SECTION 5

Please indicate well location X 5

ADDITIONAL INFORMATION

If more than one screen,
show locations of each on sketch.