

MISSISSIPPI DEPARTMENT OF NATURAL RESOURCES

Bureau of Land and Water Resources

Southport Mall

P.O. Box 10631

Jackson, Mississippi 39209

WATER WELL DRILLERS LOG

HARRISON
D 2018
5/1/81

5/1/81 19 Lyman Well Co. Harrison
date well completed firm name county well located


LANDOWNER: Billy Sinn
5012 Potomac Dr.
Pascagoula 39567
(mailing address)

description of formations encountered	from	to
<u>Sand (white)</u>	<u>0</u>	<u>60</u>
<u>Blue Clay</u>	<u>60</u>	<u>220</u>
<u>Sand</u>	<u>220</u>	<u>250</u>

WELL LOCATION:
? sec 32 T 6 N R 10 E
5 S W
10 miles N of Bohport
(distance) (direction) (nearest town)

WELL PURPOSE: None
(home, irrigation, municipal, industrial)


- WELL COMPLETION DATA:
- (1) diameter (inches) 2"
 - (2) total depth (feet) 220'
 - (3) static water level (feet) 9 below above top of ground.
 - (4) casing PVC 270'
(material) (depth)
2" if telescope see back.
(size)
 - (5) screen 10' 270'
(length) (depth to top)
2" PVC
(size) (material)
 - (6) pump N/A N/A
(HP) (y/a/d gpm)
Electric
(type power)
 - (7) electric log No
(yes or no)
No
(organization running log)
 - (8) how well bottom plugged Sand
Shark

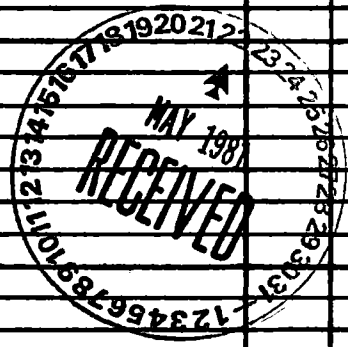

DRILLERS REMARKS:

If well telescopes please sketch and show depths.

GROUND LEVEL

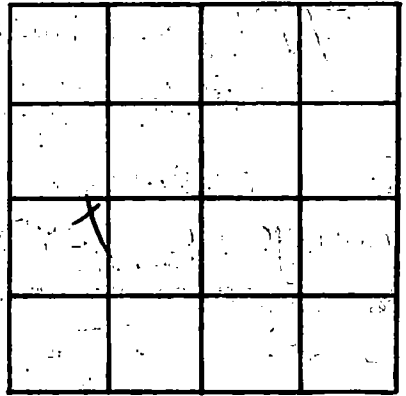

SECTION _____

Please indicate well location X.

ADDITIONAL INFORMATION

If more than one screen, show locations of each on sketch.