

MISSISSIPPI DEPARTMENT OF NATURAL RESOURCES

Bureau of Land and Water Resources

Southport Mall

P.O. Box 10631

Jackson, Mississippi 39209

COASTAL DRILLING & SERVICE CO. WATER WELL DRILLERS LOG

ROUTE 1 BOX 618

Harrison

Harrison
D
2024

5/28/82 date well completed

BILOXI, MISS 39532 firm name

county well located

LANDOWNER

Chas. Sullivan

description of formations encountered

from to

Rt 5 Box 194
Biloxi Ms
(mailing address)

<i>top soil</i>	<i>1</i>	<i>3</i>
<i>Red Clay</i>	<i>3</i>	<i>16</i>
<i>white sand</i>	<i>16</i>	<i>40</i>
<i>Super Sand</i>	<i>40</i>	<i>65</i>
<i>Soft Blue Clay</i>	<i>65</i>	<i>210</i>
<i>fine water sand</i>	<i>210</i>	<i>235</i>
<i>hard blue clay</i>	<i>235</i>	<i>280</i>
<i>fine water sand</i>	<i>280</i>	<i>305</i>
<i>good water sand</i>	<i>305</i>	<i>325</i>

WELL LOCATION:

36 T 5 N R 10 E
(1) 1/2 mile East of Lone Branch
(distance) (direction) (nearest town)

WELL PURPOSE:

home
(home, irrigation, municipal, industrial)

WELL COMPLETION DATA:

- (1) diameter (inches) *4 1/2"*
- (2) total depth (feet) *325*
- (3) static water level (feet) *45* below above top of ground
- (4) casing *4 1/2"* (material), *310'* (depth)
- 4 1/2"* (size) If telescope see back.
- (5) screen *15'* (length), *310'* (depth to top)
- 2"* (size), *PVC* (material)
- (6) pump *1/2* (HP), *18* (yield gpm)
- Ele* (type power)
- (7) electric log *no* (yes or no)

(organization running log)

(8) how well bottom plugged *2 inch with valve*

DRILLERS REMARKS: *19-5*

DEPT. OF NATURAL RESOURCES
BUREAU OF LAND & WATER RESOURCES

DEC-1 1982
RECEIVED

If well telescopes please sketch and show depths.

GROUND LEVEL

160'-4" PVC casing




150'-2" PVC casing

15'-2" PVC screen

2" hole well valve
19-B

If more than one screen, show locations of each on sketch.

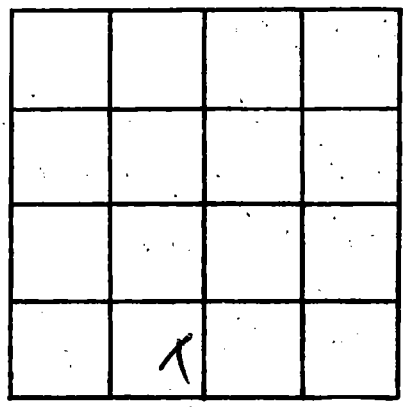

SECTION _____

Please indicate well location X.

ADDITIONAL INFORMATION

Lined area for additional information.