

MISSISSIPPI DEPARTMENT OF NATURAL RESOURCES

Bureau of Land and Water Resources

Southport Mall

P.O. Box 10631

Jackson, Mississippi 39209

WATER WELL DRILLERS LOG

Harrison
D
2025

12-9
 date well completed

828 Frank Price Harrison
 firm name

county well located

LANDOWNER:
Ronald Basuge
 (mailing address)

description of formations encountered	from	to
<u>Top Soil</u>	<u>0</u>	<u>3</u>
<u>Blue Clay</u>	<u>3</u>	<u>189</u>
<u>Fin Sand</u>	<u>189</u>	<u>220</u>
<u>Blue Clay</u>	<u>220</u>	<u>330</u>
<u>Course Sand</u>	<u>330</u>	<u>345</u>

WELL LOCATION:
 sec. 10 T. 5 S. R. 10 W.
1.6 miles E of Sucreek
 (distance) (direction) (nearest town)

WELL PURPOSE: HOME
 (home, irrigation, municipal, industrial)

WELL COMPLETION DATA:

(1) diameter (inches) 2"

(2) total depth (feet) 345'

(3) static water level (feet) 58 below top of ground

(4) casing Plastic 335'
 (material) (depth)

_____ If telescope see back.
 (size)

(5) screen 10 335'
 (length) (depth to top)

2" Plastic
 (size) (material)

(6) pump 1 9
 (HP) (yield gpm)

Elect
 (type power)

(7) electric log NO
 (yes or no)

_____ (organization running log)

(8) how well bottom plugged Backwash valve

DEPT. OF NATURAL RESOURCES
 BUREAU OF LAND & WATER RESOURCES


JAN - 6 1983

RECEIVED

DRILLERS REMARKS:

If well telescopes please sketch and show depths.

GROUND LEVEL

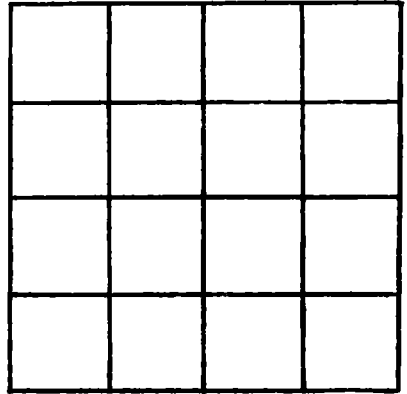

SECTION _____

Please indicate well location X.

ADDITIONAL INFORMATION

If more than one screen, show locations of each on sketch.