

MISSISSIPPI DEPARTMENT OF NATURAL RESOURCES

Bureau of Land and Water Resources

Southport Mall

P.O. Box 10631

Jackson, Mississippi 39209

WATER WELL DRILLERS LOG
COASTAL DRILLING & SERVICE CO.

Harrison
D
2026

8/8/83
date well completed

ROUTE 1 BOX 618

Harrison
county well located

BILOXI, MISS. 39532

LANDOWNER

Don Williams

description of formations encountered

from

to

Rt 2

Top Soil

1

3

Saucier MS
(mailing address)

Red Clay

3

15

WELL LOCATION:

sec. 35 T. 5 N. R. 10 E.
S. W.

Red Sand

15

30

Long Branch mile, Branch of
(distance) (direction) (nearest town)

Coarse white Sand

30

45

WELL PURPOSE: Home
(home, irrigation, municipal, industrial)

Soft Blue Clay

45

60

WELL COMPLETION DATA:

- (1) diameter (inches) 4 1/2"
- (2) total depth (feet) 360'
- (3) static water level (feet) 40' ^{below} / _{above} top of ground.

Coarse white Sand

60

110

- (4) casing PDC, 345'
(material) (depth)

Soft Blue Clay

110

230

- (5) screen 15', 345'
(length) (depth to top)

Hard Blue Clay

230

310

- (6) pump 1 1/2 (HP), 25 (yield gpm)

fine water Sand

310

325

- (7) electric log No (yes or no)

Good water Sand

325

360

- (8) how well bottom plugged 2" (sand wash) valve

DRILLERS REMARKS: 9-6

(organization running log)

(8) how well bottom plugged

DRILLERS REMARKS: 9-6

DEPT. OF NATURAL RESOURCES
BUREAU OF LAND & WATER RESOURCES

AUG 12 1983

RECEIVED

If well telescopes please sketch and show depths.


GROUND LEVEL

160' - 4" PVC casing

185' - 2" PVC casing

15' 2" PVC screen

2" pad wall valve
19-13

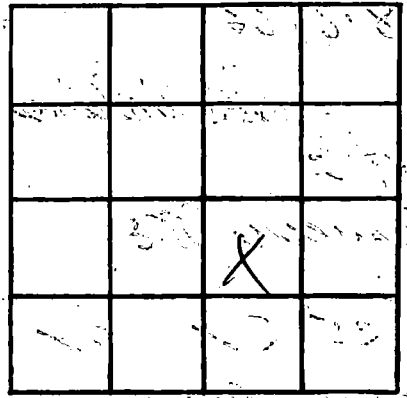

SECTION _____

Please indicate well location X.

ADDITIONAL INFORMATION

A series of horizontal lines for recording additional information, currently blank.

If more than one screen, show locations of each on sketch.