

MISSISSIPPI DEPARTMENT OF NATURAL RESOURCES

Bureau of Land and Water Resources

Southport Mall

P.O. Box 10631

Jackson, Mississippi 39209

WATER WELL DRILLERS LOG

Harrison
D
2027

Sev. Inc.

9/6 1983 Braden Pump & Well Harrison
 date well completed firm name county well located

LANDOWNER: George Carroll
Rt. 2, Box 237-G
Saucier, Ms. 39574
 (mailing address)

description of formations encountered	from	to
Clay	0	30
sand	30	78
Clay	78	80

WELL LOCATION:
 sec. 16 T 5 S R 9 E
15 miles east of Saucier
 (distance) (direction) (nearest town)

WELL PURPOSE: home
 (home, irrigation, municipal, industrial)

WELL COMPLETION DATA:

- (1) diameter (inches) 4"
- (2) total depth (feet) 80'
- (3) static water level (feet) 24' below top of ground.
- (4) casing PVC, 70'
 (material) (depth)
4" if telescope see back.
 (size)
- (5) screen 10', 70'
 (length) (depth to top)
4", PVC
 (size) (material)
- (6) pump 1, 15
 (HP) (yield gpm)
230V
 (type power)
- (7) electric log no
 (yes or no)
 (organization running log)
- (8) how well bottom plugged PVC
sandshark

DRILLERS REMARKS: no
tailpipe


DEPT. OF NATURAL RESOURCES
 BUREAU OF LAND & WATER RESOURCES

SEP 12 1983

RECEIVED

If well telescopes please sketch and show depths.

GROUND LEVEL

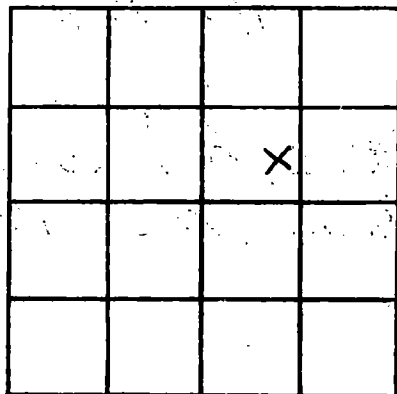

SECTION 6

Please indicate well location X.

ADDITIONAL INFORMATION

If more than one screen, show locations of each on sketch.