

MISSISSIPPI DEPARTMENT OF NATURAL RESOURCES

Bureau of Land and Water Resources

Southport Mall

P.O. Box 10631

Jackson, Mississippi 39209

WATER WELL DRILLERS LOG

Harrison
D 2029
5-7-85

5-7 1985 Frank Price Harrison
date well completed firm name county well located


LANDOWNER:	description of formations encountered		from	to
Calvin Jones	Top Soil		0	1
(mailing address)	Clay		1	180
WELL LOCATION:	Thin Sand		180	195
sec. 14 T. 5 N. R. 10 W. Camp Branch	Coarse Sand		195	207
1/4" miles E of (distance) (direction) (nearest town)				
WELL PURPOSE: HOME (home, irrigation, municipal, industrial)				
WELL COMPLETION DATA:				
(1) diameter (inches) 2				
(2) total depth (feet) 207				
(3) static water level (feet) 40' below top of ground				
(4) casing PVC, 197' (material) (depth)				
(size) If telescope see back.				
(5) screen 10', 197' (length) (depth to top)				
2" PVC (size) (material)				
(6) pump 1 (HP) 10 (yield gpm)				
Elect (type power)				
(7) electric log NO (yes or no)				
(organization running log)				
(8) how well bottom plugged				
GWV				
DRILLERS REMARKS:				

RECEIVED
JUN 18 1985

Department of Natural Resources
Bureau of Land & Water Resources

If well telescopes please sketch and show depths.

GROUND LEVEL

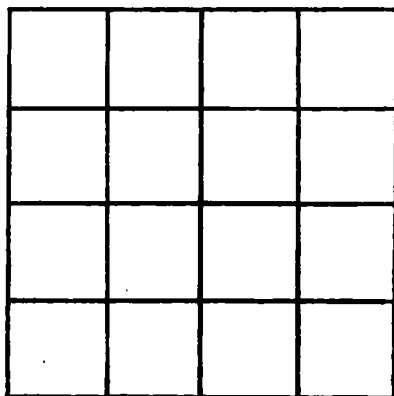

SECTION _____

Please indicate well location X.

ADDITIONAL INFORMATION

If more than one screen,
show locations of each on sketch.