

MISSISSIPPI DEPARTMENT OF NATURAL RESOURCES

Bureau of Land and Water Resources

Southport Mall

P.O. Box 10631

Jackson, Mississippi 39209

WATER WELL DRILLERS LOG

Harrison  
D 2030  
6-6-85

6-6-85

Core Water Well Sew. Harrison  
Jackson

date well completed

firm name

county well located

LANDOWNER:

Angie Holley  
Rt 6 - Box 436 A  
North Biloxi, Miss.  
(mailing address)

description of formations encountered

from to

WELL LOCATION:

sec. 30 T 5 N R 9 E  
5 miles SW of LARUE  
(distance) (direction) (nearest town)

Top soil 0 1  
Red Clay 1 15'  
Blue Clay 15' 30'  
Red fine sand 30' 25'  
Blue Clay 25' 105'  
Red coarse sand 105' 122'  
Blue Clay 122' 258'  
Gray coarse sand 258' 277'  
Blue Clay 277' 280'  
5'-2" Tail Rope

WELL PURPOSE:

(home, irrigation, municipal, industrial)

None

WELL COMPLETION DATA:

- (1) diameter (inches) 2"
- (2) total depth (feet) 280'
- (3) static water level (feet) 65' below above top of ground.
- (4) casing PVC 270' (material) (depth)  
2" (size) if telescope see back.
- (5) screen 10' 270' (length) (depth to top)  
2" (size) PVC (material)
- (6) pump 1/2 HP 8 1/2 (HP) (yield gpm)  
Check (type power)
- (7) electric log No (yes or no)

(organization running log)

(8) how well bottom plugged

Back Water Valve


DRILLERS REMARKS:

RECEIVED  
JUL 11 1985

Department of Natural Resources  
Bureau of Land & Water Resources

If well telescopes please sketch and show depths.

GROUND LEVEL

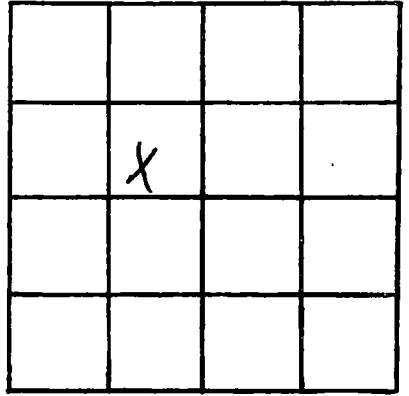

SECTION 30

Please indicate well location X.

**ADDITIONAL INFORMATION**

If more than one screen, show locations of each on sketch.