

MISSISSIPPI DEPARTMENT OF NATURAL RESOURCES
Bureau of Land and Water Resources

P.O. Box 10631

Jackson, Mississippi 39209
WATER WELL DRILLERS LOG

COUNTY WELL LOCATED HARRISON
WELL NUMBER D 203R
CODED
DATE WELL COMPLETED 8-29-86

PERMIT NUMBER
NAME OF DRILLING FIRM Coast Water Well

NAME & MAILING ADDRESS OF LANDOWNER Glenn Humphrey			
Rt 2 Box 237 A-2			
Souder, MS. 391574			
WELL LOCATION:	SEC	TOWNSHIP	RANGE
	6	5	9 E
DISTANCE	DIRECTION	NEAREST TOWN	
13 Miles	N	of D'BERVILLE	
OTHER LANDMARK			
WELL PURPOSE: Home, Irrigation, Municipal, Industrial, Fish Pond, etc. home			

PUMP DATA		
PUMP TYPE (Circle One): Submersible, Turbine, Jet Flowing Well, Other (Describe) _____		
POWER TYPE (Circle One): Electric , Tractor, Diesel, Gasoline, Butane, Other (Describe) _____		
Pump Capacity (GPM)	No. of Stages	Setting Depth
6	2	90 FT.
PUMP TEST		
Well yielded _____ GPM with a drawdown of _____ ft. after _____ hours of pumping		

WELL DATA		
Well Depth 268'	Casing Diameter (In.) 2"	Casing Length (Ft.) 253'
Type of Casing PVC	Hole Depth 263'	Depth to Static Water Level 71'
TYPE OF COMPLETION: (Circle One or More): Natural Development , Gravel Packed, Underreamed, Telescoped, Open Hole, Other		
Top of Lap Pipe or Reduction in Casing FEET IF TELESKOPED OR MORE THAN ONE SCREEN: USE BACK PAGE		

LOG DATA	
TYPE OF LOG RUN (Circle One): No Log Run , Electric, Gamma Ray, Density, Sonic, Neutron, Other (Describe) _____	
Name of Organization Running Log _____	

SCREEN DATA		
Diameter - Inches 2"	Length - Feet 10'	Slot Size - Inches .008
Screen Type PVC	Depth to Bottom - Feet 263'	


GEOLOGIC DATA (Office Use Only)			
Surface Elev.	Geologic Unit	Unit Thickness	Depth to Top
Subs. SWL	Date	Analysis	Aquifer Test
Driller's Remarks			

DESCRIPTION OF FORMATIONS ENCOUNTERED	FROM	TO	FORMATIONS (Continued)		FROM	TO
			FORMATION	DEPTH		
Top Soil	0	1	Gravelly Sand	170	215	
Red Clay	1	45	Blue Clay	215	250	
Blue Clay	45	60	Gray med sand	250	263	
Red med sand	60	102	Blue Clay	215	263	
Blue Clay	102	172				
Blue Clay + Streak of sand	172	190				

IF MORE SPACE IS NEEDED, USE BACK

If well telescopes please sketch and show depths.

GROUND LEVEL

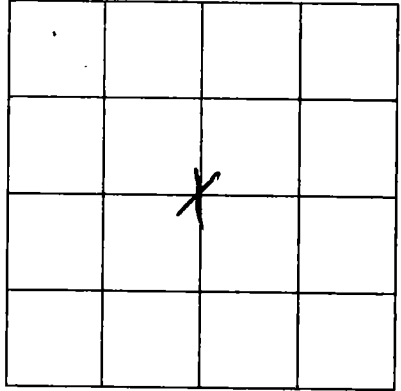

SECTION 6

Please indicate well location X.

ADDITIONAL INFORMATION

If more than one screen,
show location of each on sketch.