

MISSISSIPPI DEPARTMENT OF ENVIRONMENTAL QUALITY

Office of Land and Water Resources

P. O. Box 10631
Jackson, MS 39289-0631

WATER WELL DRILLERS LOG

COUNTY WELL LOCATED
Harrison

WELL NUMBER CODED
12043

DATE WELL COMPLETED
9-21-99

PERMIT NUMBER

NAME OF DRILLING FIRM
Coast Water Well Service

NAME & MAILING ADDRESS OF LANDOWNER
Jeff Mallett
Ramsay Creek Rd
Beloxi Ms

WELL LOCATION: SEC *29* TOWNSHIP *4^N* RANGE *9^{EW}*

DISTANCE *17* Miles DIRECTION *NORTH* of NEAREST TOWN *Beloxi*

OTHER LANDMARK

WELL PURPOSE: Home Irrigation, Municipal, Industrial, Fish Pond, etc.

PUMP DATA

PUMP TYPE (Circle One):
Submersible, Turbine, Jet, Flowing Well,
Other (Describe) _____

POWER TYPE (Circle One):
Electric, Tractor, Diesel, Gasoline, Butane,
Other (Describe) _____ H/P _____

Pump Capacity (GPM) _____ No. of Stages _____ Setting Depth _____ FT.

PUMP TEST

Well yielded _____ GPM with
a drawdown of _____ ft.
after _____ hours of pumping

WELL DATA

Well Depth *310'* Casing Diameter (In.) *2"* Casing Length (Ft.) *295'*

Type of Casing *PVC* Hole Depth *310'* Depth to Static Water Level *60'*

LOG DATA

TYPE OF LOG RUN (Circle One):
Electric, Gamma Ray, Density, Sonic, No Log Run, Neutron,
Other (Describe) _____

Name of Organization Running Log _____

TYPE OF COMPLETION: (Circle One or More):
 Gravel Packed, Underreamed, Telescoped,
 Natural Development, Open Hole, Other
(Describe) _____

GEOLOGIC DATA (Office Use Only)

Surface Elev.	Geologic Unit	Unit Thickness	Depth to Top
Subs. SWL	Date	Analysis	Aquifer Test

WELL GROUTED TO A DEPTH OF *20* FEET
Type Grout (circle one): Cement, Bentonite, or Mix

Driller's Remarks

Top of Lap Pipe or Reduction in Casing

FEET IF TELESCOPED OR MORE THAN ONE SCREEN: USE BACK PAGE

SCREEN DATA

Diameter - Inches *2"* Length - Feet *15'* Slot Size - Inches *.008*

Screen Type *PVC* Depth to Bottom - Feet *310'*

DESCRIPTION OF FORMATIONS ENCOUNTERED	FROM	TO
<i>Top Soil</i>		
<i>Blue Clay</i>	<i>0</i>	<i>80</i>
<i>Gray Med Sand</i>	<i>80</i>	<i>125</i>
<i>Blue Clay</i>	<i>125</i>	<i>245</i>
<i>Gray Coarse Sand</i>	<i>245</i>	<i>310</i>

RECEIVED


DEC 28 1999

Dept. of Environmental Quality
Office of Land & Water Resources

IF MORE SPACE IS NEEDED, USE BACK

If well telescopes please
sketch and show depths.

GROUND LEVEL

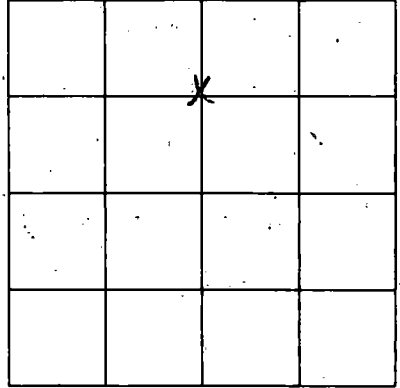

SECTION

29

Please indicate well location X.

ADDITIONAL INFORMATION

RECEIVED

DEC 11 1983

Office of Land & Water Resources
Dept. of Environment & Conservation

If more than one screen,
show location of each on sketch.