

HAR.

MISSISSIPPI BOARD OF WATER COMMISSIONERS

F 20

WATER WELL DRILLERS LOG

8-17-61

Date: 8-17, 1961, Driller: C. T. SWITZER WELL CO. County Harrison

(Name)

(1) Owner of Land:	Description & Color of Materials Sand, Clay, Red Clay, Shell, etc.	Thick- ness Feet	Depth Feet
Loyal Murphy (Name)	clay	0	10
Star Rt, Sautter (Address)	sand	10	20
(2) Location: 1/4, 1/4, Sec. T. R.	clay	20	41
miles of (distance) (direction) (Nearest Town)	sand	41	51
(3) Topography: X (Hilly) (Flat) (Level)	clay	51	94
(4) Purpose of Well: Domestic (Domestic Irrigation Municipal, Industrial, Other)	good sand	94	146
	clay	146	206
	good sand	206	284


Information upon completion of well:

- (1) Diameter 2" inches.
- (2) Total Depth 284' feet.
- (3) Water level 10' feet below top of ground.
- (4) Cased to 284, Size 2"
- (5) Screen: Size 2", Length 10'
- (6) Were all formations sealed against pollution?
X yes, no.

If YES depth of formation

Why Health Dept Requirement

Drillers Remarks:

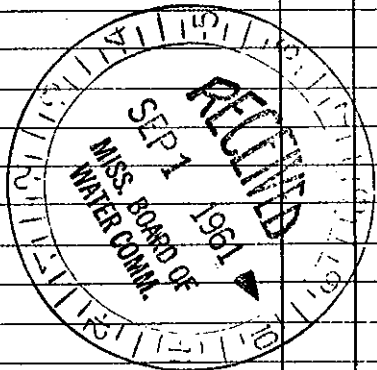

(Use Back Side)

Well No.

Mail this copy to Board of Water Commissioners 429 Miss. St. Jackson, Miss.