

HAR.
E3
8-2-60

WATER WELL DRILLERS LOG ~~302~~ ^E - 302

Date: 8-2, 1960, Driller: Joseph N. Miller County Harrison
(Name)

(1) Owner of Land: Subert Lopez
(Name)
R# 2 Box 201 Gulfport
(Address)

(2) Location: 1/4, 1/4, Sec. T R ,
15 miles NW, of Gulfport
(distance) (direction) (Nearest Town)

(3) Topography: Hilly
(Hilly) (Flat) (Level)

(4) Purpose of Well: Domestic
(Domestic Irrigation
Municipal, Industrial, Other)

| Description & Color of Materials Sand, Clay, Red Clay, Shell, etc. | Thick- ness Feet | Depth Feet |
|---|------------------------|---------------|
| <u>Surface Sand</u> | <u>5</u> | <u>5</u> |
| <u>Red Sand Slit</u> | <u>13</u> | <u>18</u> |
| <u>Red Sand & Clay</u> | <u>32</u> | <u>50</u> |
| <u>Brown Sand & Gravel</u> | <u>18</u> | <u>68</u> |
| <u>White Clay Fresh Blue</u> <u>now & then</u> | <u>12</u> | <u>180</u> |
| <u>Lava Sand & Gravel</u> | <u>141</u> | <u>221</u> |
| <u>Brown Wh & Blue</u> <u>Clay (Darker Top)</u> | | |

Information upon completion of well:

(1) Diameter 2 inches.

(2) Total Depth 222' feet.

(3) Water Level 68' feet below top of ground.

(4) Cased to 210', Size 2'


(5) Screen: Size 2, Length 10'

(6) Were any formations sealed against pollution?
 yes, no.

If YES depth of formation

Why

Drillers Remarks:

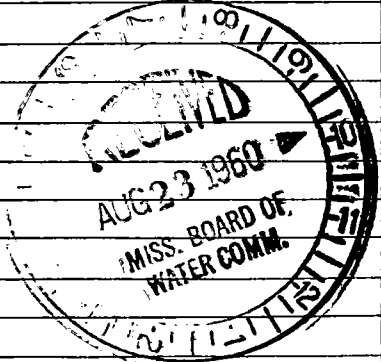

over

(Use Back Side)

Well No.

JA-HRu

Hyman



S3

Catholic
~~Catholic~~
Church



to Sauer's