

HAR.

MISSISSIPPI BOARD OF WATER COMMISSIONERS

E 4

11-20-60

WATER WELL DRILLERS LOG

CODED 314

Date: 11-20, 1960, Driller: Joe Miller County Harrison

(Name)

(1) Owner of Land: Mrs. Ludwig Jr (Name)

Rt 2 Box 220-B Shell Road (Address)

(2) Location: 1/4, 1/4, Sec 12 or 13 T6 R13 S (Nearest Town)

miles of (distance) (direction) (Nearest Town)

(3) Topography: Hilly (Hilly) (Flat) (Level)

(4) Purpose of Well: Domestic (Domestic Irrigation Municipal, Industrial, Other)

Description & Color of Materials Sand, Clay, Red Clay, Shell, etc.

Thick-ness Feet

Depth Feet

Surface	12	12
Wh Sand + Gravel	36	48
Blue Clay	12	60
Sand & Clay w/ Br.	30	90
Blue Clay	44	234
Fine Gray Sand NG	25	259
Blue Clay Hd.	118	377
Fine Gray Sand	10	387
Fine	11	398
Gray Sand (test hole)	29	427
Sand hitting	3	430
finer		

Information upon completion of well:

(1) Diameter 2" inches.

(2) Total Depth 429' feet.

(3) Water Level 22' feet below top of ground.

(4) Cased to 417, Size 2"

(5) Screen: Size 2", Length 10'


(6) Were any formations sealed against pollution? yes, no.

If YES depth of formation

Why

Drillers Remarks:


CODED

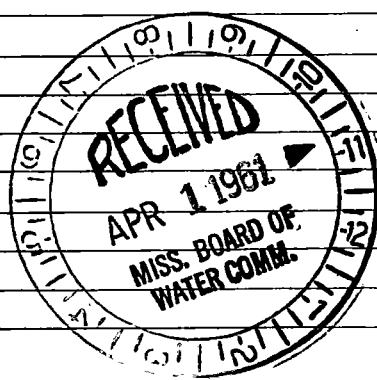

(Use Back Side)

Well No.

8

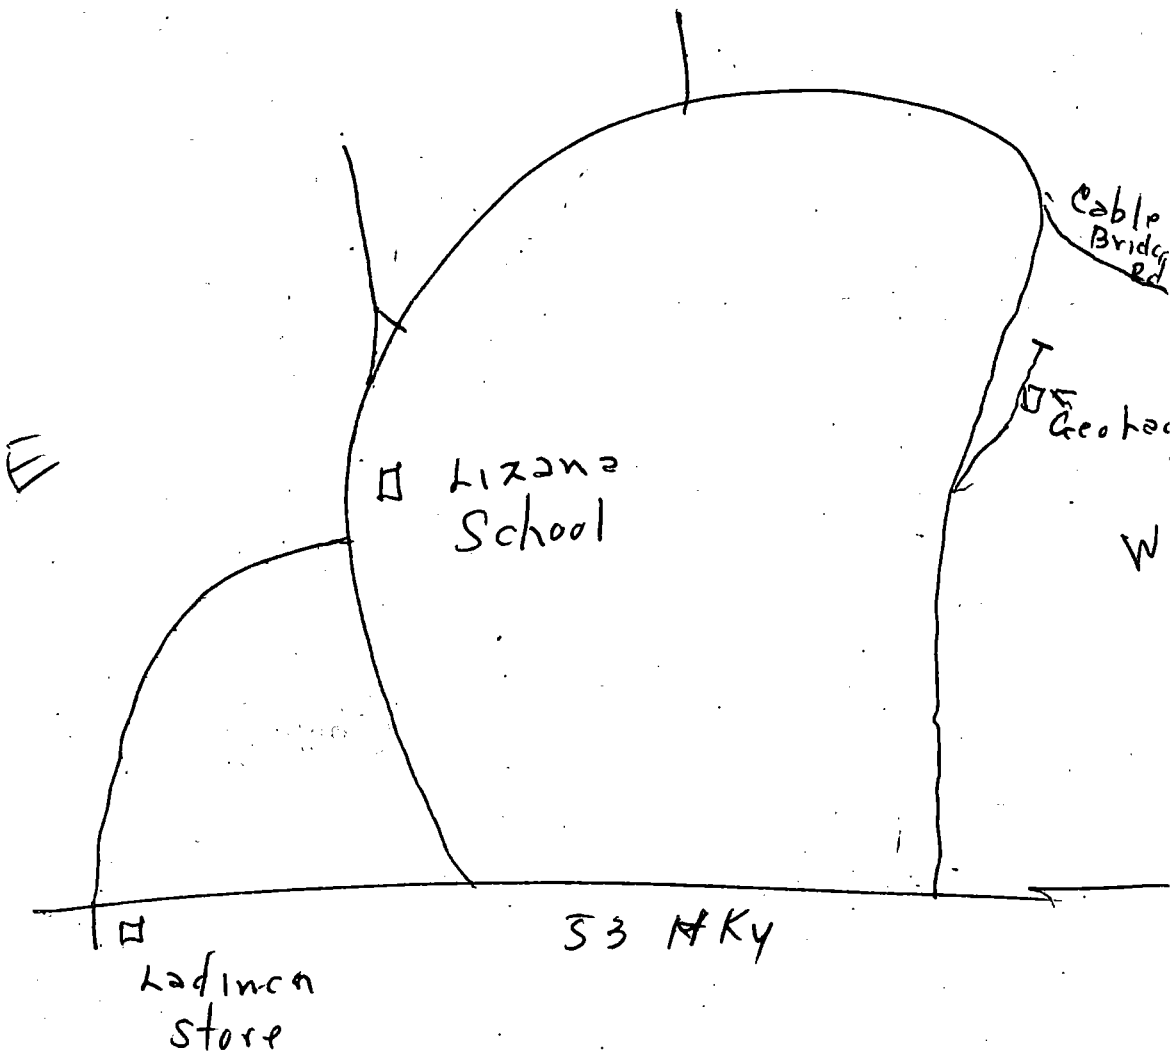

N