

HAR.  
E5

MISSISSIPPI BOARD OF WATER COMMISSIONERS

?

WATER WELL DRILLERS LOG

Date: 12-28, 1960, Driller: J. Reed County Admission

(Name)

(1) Owner of Land: Violette Borg  
(Name)

Rt 1 Saucier Miss  
(Address)  
Mutton Ridge

(2) Location: 1/4, 1/4, Sec.     T.     R.      
8 miles west of Sigena  
(distance) (direction) (Nearest Town)

(3) Topography: X (Hilly) (Flat) (Level)

(4) Purpose of Well: Home use  
(Domestic Irrigation, Municipal, Industrial, Other)

Description & Color of Materials Sand, Clay, Red Clay, Shell, etc.	Thick- ness Feet	Depth Feet
<u>20 ft Red clay</u>		<u>20</u>
<u>70 " " Sand</u>		<u>90</u>
<u>80 " Blue clay</u>	<u>1</u>	<u>70</u>
<u>30 ft water sand</u>		<u>30</u>
		<u>200</u>

Information upon completion of well:

(1) Diameter 2 1/4 inches.

(2) Total Depth 200 feet.

(3) Water Level 53 ft feet below top of ground.

(4) Cased to \_\_\_\_\_, Size \_\_\_\_\_


(5) Screen: Size \_\_\_\_\_, Length \_\_\_\_\_

(6) Were any formations sealed against pollution?  
\_\_\_\_\_ yes, \_\_\_\_\_ no.

If YES depth of formation \_\_\_\_\_

Why \_\_\_\_\_

Drillers Remarks: \_\_\_\_\_

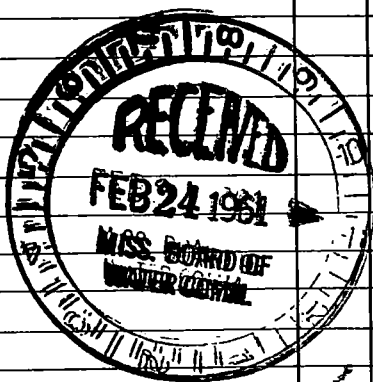

(Use Back Side)

Well No.

