

HAR.  
E 8  
5-4-61

MISSISSIPPI BOARD OF WATER COMMISSIONERS

M 524912

WATER WELL DRILLERS LOG

**CODED**

Date: 5-11, 1961, Driller: Hattisburg Bites County Harrold  
(Name)

(1) Owner of Land:	Description & Color of Materials Sand, Clay, Red Clay, Shell, etc.	Thick- ness Feet	Depth Feet
<u>Ruber DeLong</u> (Name) <u>Pass Christian, Miss</u> (Address)	<u>red clay</u>	<u>0-30</u>	<u>30</u>
	<u>red sand</u>	<u>30-60</u>	<u>60</u>
	<u>gravel</u>	<u>60-90</u>	<u>90</u>
(2) Location: <u>1/4</u> , <u>1/4</u> , Sec. <u>19 T6 R13</u> <u>20</u> miles <u>N.</u> of <u>Pass Christian</u> (distance) (direction) (Nearest Town)	<u>Blue clay</u>	<u>90-330</u>	<u>330</u>
	<u>Blue sand</u>	<u>330-350</u>	<u>350</u>
(3) Topography: <u>X</u> (Hilly) (Flat) (Level)			
(4) Purpose of Well: <u>Domestic</u> (Domestic Irrigation Municipal, Industrial, Other)			


**CODED**

Information upon completion of well:

- (1) Diameter 2 inches.
- (2) Total Depth 350 feet.
- (3) Water Level 84 feet below top of ground.
- (4) Cased to \_\_\_\_\_, Size \_\_\_\_\_
- (5) Screen: Size 2", Length 10'
- (6) Were any formations sealed against pollution?  
\_\_\_\_\_ yes, X no.

If YES depth of formation \_\_\_\_\_  
Why \_\_\_\_\_

Drillers Remarks: \_\_\_\_\_  
\_\_\_\_\_  
\_\_\_\_\_

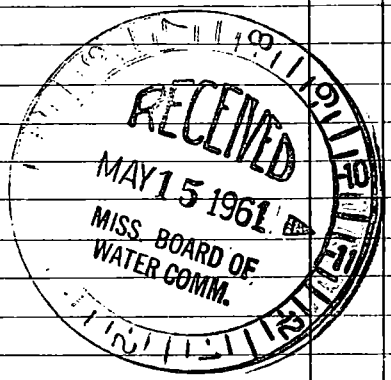

(Use Back Side)

Well No.

