

HAR.

MISSISSIPPI BOARD OF WATER COMMISSIONERS

E 9

MS 30705

5-4-61

WATER WELL DRILLERS LOG

CODED

Date: 5-4, 1961, Driller: Sutter Well Works County Harrison

(Name)

(1) Owner of Land: Purvis Malley (Name)

Rt. 1 Pass Christian Miss. (Address)

(2) Location: 1/4, 1/4, Sec. 39 31 6 13 T R

10 miles N of Sibley (distance) (direction) (Nearest Town)

(3) Topography: Hilly (Hilly) (Flag) (Level)

(4) Purpose of Well: domestic (Domestic Irrigation Municipal, Industrial, Other)

Description & Color of Materials Sand, Clay, Red Clay, Shell, etc.

Thickness Feet

Depth Feet

surface clay 10 10
red sand 84 94
clay 286 380
sand 24 404

Information upon completion of well:

(1) Diameter 2 inches.

(2) Total Depth 404 feet.

(3) Water level 78 feet below top of ground.

(4) Cased to all, Size 2"

(5) Screen: Size 2", Length 5'

(6) Were any formations sealed against pollution?


yes, no.

If YES depth of formation

Why

Drillers Remarks: Concrete slab at surface.

CODED

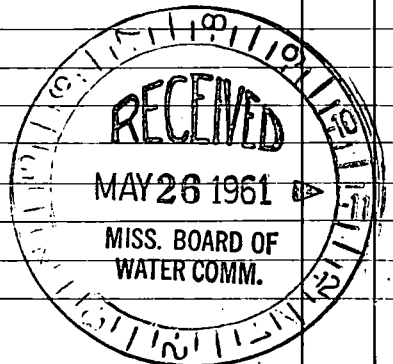

(Use Back Side)

Well No.

1940

Handwritten notes and scribbles at the top of the page, including the word "SOUTH" and other illegible characters.

Handwritten text, possibly "SOUTH" or similar, oriented vertically.

1940

Handwritten text, possibly "SOUTH" or similar.

Handwritten text, possibly "SOUTH" or similar.

Handwritten text, possibly "SOUTH" or similar.

Handwritten text, possibly "SOUTH" or similar.