

E 13  
8-20-62

WATER WELL DRILLERS LOG

**CODED**

Date: 8-20, 1962, Driller: Sutter Well Works County Harrison  
(Name)

(1) Owner of Land:	Description & Color of Materials Sand, Clay, Red Clay, Shell, etc.	Thick- ness Feet	Depth Feet
<u>Floyd Babine</u> (Name) <u>Rt. 2 Gulfport</u> (Address)	<u>Clay</u>	<u>10</u>	<u>10</u>
(2) Location: <u>SW 1/4, SW 1/4, Sec. 12 T6R13W</u>	<u>sand</u>	<u>60</u>	<u>70</u>
<u>1</u> miles <u>SW</u> , of <u>Luzina</u> (distance) (direction) (Nearest Town)	<u>Clay</u>	<u>80</u>	<u>150</u>
(3) Topography: <u>hilly</u> (Hilly) (Flat) (Level)	<u>sand</u>	<u>44</u>	<u>194</u>
(4) Purpose of Well: <u>domestic</u> (Domestic Irrigation Municipal, Industrial, Other)			

**CODED**


Information upon completion of well:

- (1) Diameter 2 inches.
- (2) Total Depth 194 feet.
- (3) Water Level 63 feet below top of ground.
- (4) Cased to all, Size 2"
- (5) Screen: Size 2", Length 5'
- (6) Were any formations sealed against pollution?  
no ✓

If YES depth of formation \_\_\_\_\_

Why \_\_\_\_\_

Drillers Remarks: \_\_\_\_\_

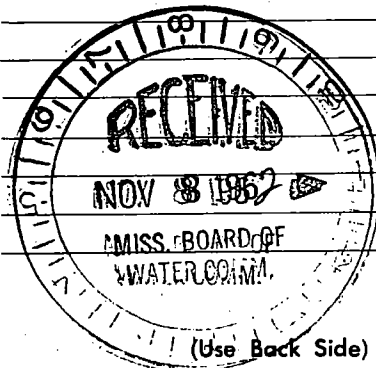

Well No.

1000

Handwritten text, possibly a name or title.

Handwritten notes or numbers.

408

51

100

5