

E 14
8-24-62

WATER WELL DRILLERS LOG

E
CODED

Date: 8-24, 1962, Driller: J. Bees County Madison
(Name)

(1) Owner of Land: J. Lee Northrup
(Name)
Rt 2. Box 205-F Sulphur
(Address)
Lot 6. Block 2
(2) Location: 1/4, 1/4, Sec. 13 T. 6 R. 13,
Silvermere subdivision
miles _____ of _____
(distance) (direction) (Nearest Town)
(3) Topography: (Hilly) (Flat) (Level)
(4) Purpose of Well: Home
(Domestic Irrigation
Municipal, Industrial, Other)


Description & Color of Materials Sand, Clay, Red Clay, Shell, etc.	Thick- ness Feet	Depth Feet
<u>Red Clay + sand</u>	<u>80</u>	<u>80</u>
<u>Blue hard mud</u>	<u>400</u>	<u>480</u>
<u>Fine sand</u>	<u>16</u>	<u>496</u>
<u>Hard Blue mud</u>	<u>46</u>	<u>542</u>
<u>water strata</u>	<u>35</u>	<u>577</u>

CODED

Information upon completion of well:

- (1) Diameter 2" x 1 1/4" inches.
(2) Total Depth 577 feet.
(3) Water Level 92 feet below top of ground.
(4) Cased to _____, Size _____
(5) Screen: Size 1/4", Length 15 ft.
(6) Were any formations sealed against pollution?
_____ yes, _____ no.

If YES depth of formation _____
Why _____
Drillers Remarks: _____

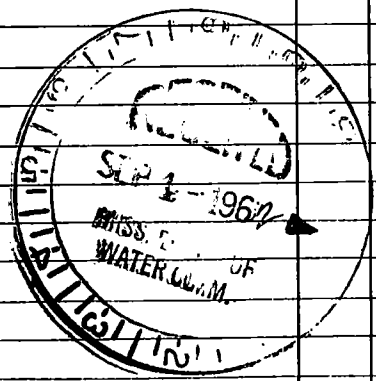

(Use Back Side)

Well No.

