

HAR.
E 17
6-17-63

WATER WELL DRILLERS LOG

Date: June 17, 1963, Driller: Joe Miller County Harrison
(Name)

(1) Owner of Land: Ferguson
(Name)
RPH Sancier
(Address)

(2) Location: 1/4, 1/4, Sec. T. R.
15 miles West, of Hyman,
(distance) (direction) (Nearest Town)

(3) Topography: Hilly
(Hilly) (Flat) (Level)

(4) Purpose of Well: Domestic
(Domestic Irrigation
Municipal, Industrial, Other)

Description & Color of Materials Sand, Clay, Red Clay, Shell, etc.	Thick- ness Feet	Depth Feet
Surface	3	3
White Clay Sand	29	32
Brown Sand,	13	45
Blk Scl. Blk Ph.	5	50
Blk Clay.	130	180
Sand - Gray - Fine	16	198
Gray Clay	47	245
Sand. Gray. Fine	13	258
Clay, Blue. Hard	32	290
Sand - Gro Fine	16	306
Sand "	52	358
" Fair	20	378
Clay, Sand. W F	6	384


Information upon completion of well:

- (1) Diameter 2" inches.
- (2) Total Depth 378 feet.
- (3) Water Level 24' feet below top of ground.
- (4) Cased to 378', Size 2"
- (5) Screen: Size 2", Length 10'
- (6) Were any formations sealed against pollution?
_____ yes, _____ no.

If YES depth of formation _____

Why _____

Drillers Remarks: _____

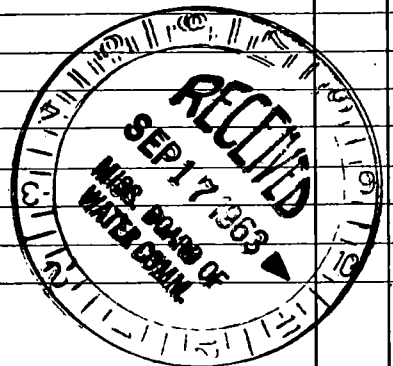

Well No.

Cable
Bridge

Walker R.

Ferguson

PK4 09

Kyman

53.