

CODED

E 19

WATER WELL DRILLERS LOG

8-23-63

Date: 8-23, 1963, Driller: Sutter Well Works County Harrison
(Name)

(1) Owner of Land: J.C. Ladner
(Name)
Rt 1 Pass Christian
(Address)

(2) Location: NW 1/4, SW 1/4, Sec. 33 T6S R13, W4
3 miles E of Vidalia
(distance) (direction) (Nearest Town)

(3) Topography: hilly
(Hilly) (Flat) (Level)

(4) Purpose of Well: domestic
(Domestic Irrigation
Municipal, Industrial, Other)

Description & Color of Materials Sand, Clay, Red Clay, Shell, etc.	Thick- ness Feet	Depth Feet
Clay	27	27
sand - gravel	28	55
Clay - sand streaks	88	147
sand	53	200
Clay	95	295
sand & clay	40	335
sand sand	14	349
Clay	25	374
sand	63	437

Information upon completion of well:

(1) Diameter 2 inches.

(2) Total Depth 437 feet.

(3) Water Level 61 feet below top of ground.

(4) Cased to all, Size 2"

(5) Screen: Size 2", Length 10'


(6) Were any formations sealed against pollution?
no yes, no.

CODED

If YES depth of formation _____

Why _____

Drillers Remarks: _____

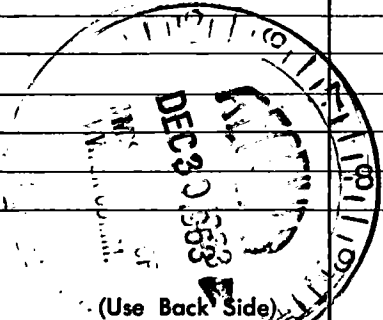

Well No. _____

1000

1000

