

CODED

E 20 M524411

10-7-63 WATER WELL DRILLERS LOG

Date: OCT 7, 1963, Driller: Hattiesburg Butte County Harrison
(Name)

(1) Owner of Land: Ber B. Deschamps
(Name)
Rt 2 Guypert, Miss
(Address)

(2) Location: $\frac{1}{4}$, $\frac{1}{4}$, Sec. 12 T6 R13
Pizana
_____ miles _____ of _____
(distance) (direction) (Nearest Town)

(3) Topography: Hilly
(Hilly) (Flat) (Level)

(4) Purpose of Well: domestic
(Domestic Irrigation
Municipal, Industrial, Other)

Description & Color of Materials Sand, Clay, Red Clay, Shell, etc.	Thick- ness Feet	Depth Feet
<u>yellow clay</u>	<u>0-12</u>	
<u>gravel</u>	<u>12-35</u>	
<u>red clay</u>	<u>35-45</u>	
<u>white clay</u>	<u>45-58</u>	
<u>blue clay</u>	<u>58-160</u>	
<u>blue sand</u>	<u>160-170</u>	
<u>blue clay</u>	<u>170-245</u>	
<u>blue sand</u>	<u>245-275</u>	

Information upon completion of well:

(1) Diameter 2 inches.

(2) Total Depth 275 feet.

(3) Water Level 100 feet below top of ground.

(4) Cased to _____, Size _____


(5) Screen: Size 2", Length 10'

(6) Were any formations sealed against pollution?
_____ yes, _____ no.

If YES depth of formation _____

Why _____

Drillers Remarks: _____

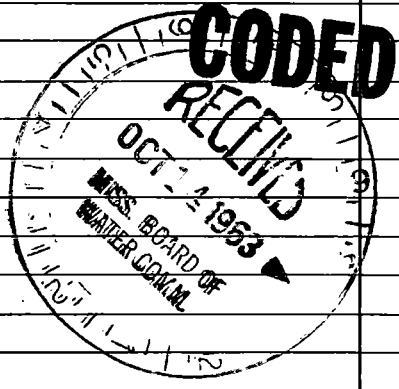

(Use Back Side)

Well No.

