

E22

WATER WELL DRILLERS LOG

K

3-5-64

Date: Mar 5, 1964, Driller: Joe Miller County: Hancock
 (Name)

(1) Owner of Land: Dwelling
 (Name)
RPA Pass Christian Mills
 (Address)
 (2) Location: 1/4, 1/4, Sec. T R
1.5 miles North, of Pass Christian
 (distance) (direction) (Nearest Town)
 (3) Topography: Hilly
 (Hilly) (Flat) (Level)
 (4) Purpose of Well: Domestic
 (Domestic Irrigation
 Municipal, Industrial, Other)


Description & Color of Materials Sand, Clay, Red Clay, Shell, etc.	Thick- ness Feet	Depth Feet
Surface	5	5
Brown Clay	5	10
1/2 Gravel	2	12
Red Clay	13	25
Pink Clay	25	50
Fine Sand Fine.	4	54
White Clay	18	72
Blue Clay (light)	58	130
White Clay	28	158
Fine Fine Sand. W.R.	29	187
Iron Rock (Cap rock)	2	189
Brown Clay.	3	192
Gray Clay	8	200
Hard Blue Clay	98	298
Fine Sand (Cut bluff)	37	335
Hard Blue Clay	55	390
Loose Fine Gravel	12	432
Coarse Gray Sand	29	461
Hard Blue Clay	3	464

Information upon completion of well:

(1) Diameter 2" inches.
 (2) Total Depth 464 feet.
 (3) Water Level 51' feet below top of ground.
 (4) Cased to 450, Size 2"
 (5) Screen: Size 2", Length 10'
 (6) Were any formations sealed against pollution?
 _____ yes, _____ no.

5' Jail lift.

If YES depth of formation _____
 Why _____
 Drillers Remarks: _____

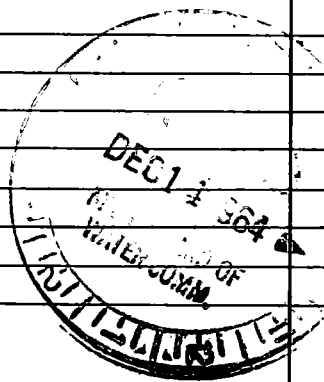

(Use Back Side)

Well No.

Switzer
Recreational School

Wolf Pine

Cable Bridge

Logan School

53

Highway

7 South

Apr 99